

**KEMPER MISSISSIPPI BOARD OF**

L 7

CODED **WATER WELL DRILLERS LOG**

L300

10-12-60

Date: Oct. 12, 1960, Driller: Ferry Drilling Co., County Kemper  
(Name)

(1) Owner of Land: <u>U.S. Government</u> (Name) <u>Moscow, Miss.</u> (Address)	Description & Color of Materials Sand, Clay, Red Clay, Shell, etc.	Thick- ness Feet	Depth Feet
(2) Location: <u>1/4, 1/4, Sec. T. R.</u> <u>3</u> miles <u>North west</u> , of <u>Moscow</u> (distance) (direction) (Nearest Town)	<u>Red sandy Clay</u>	<u>0</u>	<u>22'</u>
	<u>Red + white sand</u>	<u>22'</u>	<u>44'</u>
(3) Topography: <input checked="" type="checkbox"/> (Hilly) <input type="checkbox"/> (Flat) <input type="checkbox"/> (Level)	<u>White sand</u>	<u>44'</u>	<u>88'</u>
	<u>Layers sand + mud</u>	<u>88'</u>	<u>115'</u>
(4) Purpose of Well: <u>Radar Tower</u> (Domestic Irrigation Municipal, Industrial, Other)	<u>Coarse sand</u>	<u>115'</u>	<u>125'</u>


Information upon completion of well:

- (1) Diameter 93 inches.
- (2) Total Depth 125 feet.
- (3) Water Level 98' feet below top of ground.
- (4) Cased to 125, Size 3"
- (5) Screen: Size 2", Length 10'
- (6) Were any formations sealed against pollution?  
no.

If YES depth of formation \_\_\_\_\_

Why Casing set straight

Drillers Remarks: \_\_\_\_\_

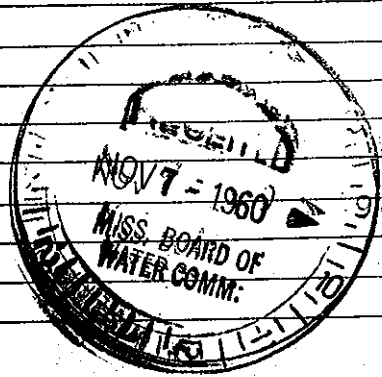

(Use Back Side)

Well No. L300

Mail this copy to Board of Water Commissioners 429 Miss. St. Jackson, Miss