

Kemper

N 3

8-66

CODED

MISSISSIPPI BOARD OF WATER COMMISSIONERS

WATER WELL DRILLERS LOG

Date: 8-28, 1966, Driller: Ogletree Drilling Co. Henry L. Watkins County Kemper


1) Owner of Land: Jimmy Dean Boyd (Name) Route 1 Dekalb (Address) 2) Location: SE 1/4, SE 1/4, Sec. 4 T19R16E, 5 miles South of DEKALB (distance) (direction) (Nearest Town) 3) Topography: (Hilly) (Flat) (Level) 4) Purpose of Well: Home Use (Domestic Irrigation Municipal, Industrial, Other)

Information upon completion of well:

- 1) Diameter 2 inches. 2) Total Depth 126 feet. 3) Water Level 100 feet below top of ground. 4) Cased to 120, Size 2" 5) Screen: Size 1/4, Length 5' 6) Were any formations sealed against pollution? yes, no.

If YES depth of formation Why Drillers Remarks: Yield in gpm: 5 Size pump: 3/4 H.P. Type power:

Table with 4 columns: Description & Color of Materials, Sand, Clay, Red Clay, Shell, etc.; Thickness Feet; Depth Feet. Contains handwritten entries for CLAY and SAND.

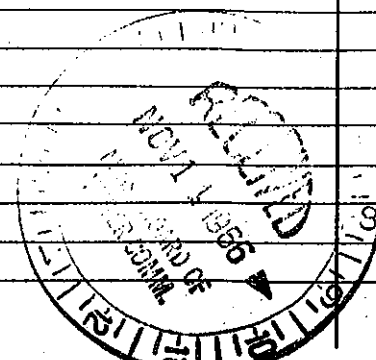

Mail this copy to Board of Water Commissioners 429 Miss. St. Jackson, Miss.