

MISSISSIPPI BOARD OF WATER COMMISSIONERS

P5

WATER WELL DRILLERS LOG

CODED

Date: 6-3, 1965, Driller: Bob Williams County Kemper
(Name)

(1) Owner of Land: <u>H. M. Miles</u> <small>(Name)</small>	Description & Color of Materials Sand, Clay, Red Clay, Shell, etc.	Thick- ness Feet	Depth Feet
<u>Rt. 5 DeKalb, Miss.</u> <small>(Address)</small>	<u>Red sand</u>	<u>10</u>	<u>1-10</u>
(2) Location: <u>1/4, 1/4 Sec. 10/8</u>	<u>Blue clay</u>	<u>130</u>	<u>10-140</u>
<u>20 miles North of Nunda</u> <small>(distance) (direction) (Nearest Town)</small>	<u>fine gray sand</u>	<u>51</u>	<u>140-191</u>
(3) Topography: <u>Hilly</u> <small>(Hilly) (Flat) (Level)</small>			
(4) Purpose of Well: <u>domestic</u> <small>(Domestic Irrigation Municipal, Industrial, Other)</small>			

Information upon completion of well:


- (1) Diameter 2 inches.
- (2) Total Depth 191 feet.
- (3) Water Level 106 feet below top of ground.
- (4) Cased to 136, Size 2"
- (5) Screen: Size 0, Length _____
- (6) Were any formations sealed against pollution?
 yes, _____ no.

If YES depth of formation _____

Why surface water

Drillers Remarks: _____

stain this copy for your office files.

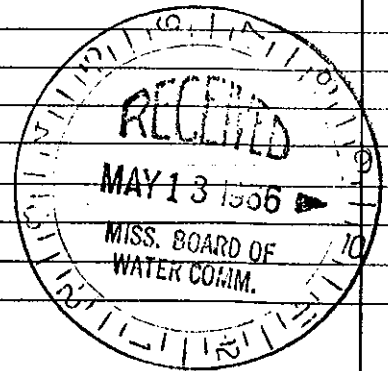

(Use Back Side)

Well No.