

KEMPER

MISSISSIPPI BOARD OF WATER COMMISSIONERS

P6

WATER WELL DRILLERS LOG

CODED

8-22-66

Date: 8/22, 1966, Driller: TERRY, County KEMPER

(1) Owner of Land: <u>C.M. RALIGHT</u> (Name)	Description & Color of Materials Sand, Clay, Red Clay, Shell, etc.	Thick- ness Feet	Depth Feet
<u>ELECTRIC MILK, MISS.</u> (Address)	<u>YELLOW CLAY</u>	<u>25</u>	<u>25</u>
(2) Location: <u>4</u> <u>10N 18E</u> 1/4, 1/4, Sec. T. R. S.	<u>BLACK SHALE</u>	<u>275</u>	<u>300</u>
<u>6</u> miles <u>SOUTH</u> of <u>SCOOBA</u> (distance) (direction) (Nearest Town)	<u>LIME ROCK</u>	<u>800</u>	<u>1100</u>
(3) Topography: <u>(Flat)</u> (Hilly) (Flat) (Level)	<u>FINE SAND</u>	<u>60</u>	<u>1160</u>
(4) Purpose of Well: <u>DOMESTIC</u> (Domestic Irrigation Municipal, Industrial, Other)	<u>SHALE + ROCK</u>	<u>280</u>	<u>1440</u>
	<u>COARSE SAND</u>	<u>75</u>	<u>1515</u>

Information upon completion of well:


- (1) Diameter 4 inches.
- (2) Total Depth 1515 feet.
- (3) Water Level 72 feet below top of ground.
- (4) Cased to 300, Size 4
- (5) Screen: Size NO, Length \_\_\_\_\_
- (6) Were any formations sealed against pollution?  
\_\_\_\_\_ yes, \_\_\_\_\_ no.

If YES depth of formation \_\_\_\_\_

Why \_\_\_\_\_

Drillers Remarks: \_\_\_\_\_

CODED

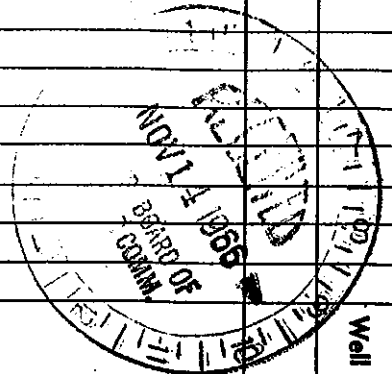

(Use Back Side)

Well No.

Mail this copy to Board of Water Commissioners 429 Miss. St. Jackson, Miss.