

KEMPER CODED WATER WELL DRILLERS LOG

Date: 8/5/64 1964, Driller: Bob Williams county Kemper
 (Name)

(1) Owner of Land:	Description & Color of Materials Sand, Clay, Red Clay, Shell, etc.	Thick- ness Feet	Depth Feet
<u>Ronnie Satter</u> (Name) <u>Route #1 Bailey</u> (Address)	<u>red clay</u> <u>red sand</u>	<u>10</u> <u>15</u>	<u>1 to 10</u> <u>10-25</u>
(2) Location: <u>NE 1/4, SW 1/4, Sec. 12 T 9 R 14 E</u> <u>20 miles north of Mendon</u> (distance) (direction) (Nearest Town)	<u>Blue clay</u> <u>Black sand</u>	<u>100</u> <u>30</u>	<u>25-145</u> <u>145-170</u>
(3) Topography: <u>Hilly</u> (Hilly) (Flat) (Level)			
(4) Purpose of Well: <u>Domestic</u> (Domestic Irrigation Municipal, Industrial, Other)			


Information upon completion of well:

- (1) Diameter 2 inches.
- (2) Total Depth 170 feet.
- (3) Water Level 116 feet below top of ground.
- (4) Cased to 140, Size 2 in.
- (5) Screen: Size 0, Length _____.
- (6) Were any formations sealed against pollution?
 yes, no.

If YES depth of formation _____

Why surface water

Drillers Remarks: _____

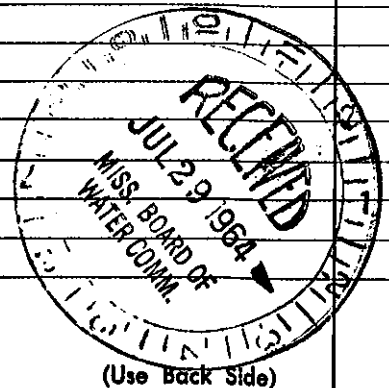

Well No. _____

Mail this copy to Board of Water Commissioners 429 Miss. St. Jackson, Miss.