

MISSISSIPPI BOARD OF WATER COMMISSIONERS

Q 3 WATER WELL DRILLERS LOG

CODED

Date: 6-23, 1965, Driller: Bob Wilkinson County Rankin
 (Name)


(1) Owner of Land: <u>Kallis Warren</u> (Name)	Description & Color of Materials Sand, Clay, Red Clay, Shell, etc.	Thick- ness Feet	Depth Feet
<u>Route 5, DeSoto, Miss.</u> (Address)	Blue <u>Blue clay</u> <u>gray sand</u>	<u>120</u> <u>30</u>	<u>1-120</u> <u>120-150</u>
(2) Location: <u>1/4, 1/4, Sec. 9 T. 14</u>			
<u>25</u> miles <u>North</u> , of <u>Merida</u> (distance) (direction) (Nearest Town)			
(3) Topography: <u>hilly</u> (Hilly) (Flat) (Level)			
(4) Purpose of Well: <u>domestic</u> (Domestic Irrigation Municipal, Industrial, Other)			

CODED

Information upon completion of well:

- (1) Diameter 2 inches.
- (2) Total Depth 150 feet.
- (3) Water Level 70 feet below top of ground.
- (4) Cased to 107, Size 2"
- (5) Screen: Size 0, Length _____
- (6) Were any formations sealed against pollution?
 yes, no.

If YES depth of formation _____
 Why surface water
 Drillers Remarks: _____

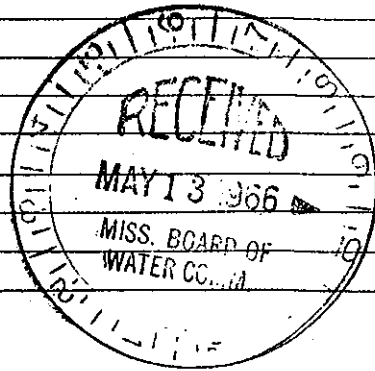

(Use Back Side)

Well No.