

CODED

KENPER MISSISSIPPI BOARD OF WATER COMMISSIONERS

R5

WATER WELL DRILLERS LOG

12-31-64

Date: 12/31, 1964, Driller: Bob Williams County Kemper
(Name)

(1) Owner of Land:	Description & Color of Materials Sand, Clay, Red Clay, Shell, etc.	Thick- ness Feet	Depth Feet
Cliff Wiggins (Name) Rt. 5, DeKalb (Address)	Red clay	10	1-10
	White clay	10	10-20
(2) Location: SE 1/4, NW 1/4, Sec. 8, T. 9, R. 15	Blue clay	140	20-160
20 miles North of Merick (distance) (direction) (Nearest Town)	fine gray sand	10	160-170
(3) Topography: Hilly (Hilly) (Flat) (Level)	Blue clay	43	170-215
(4) Purpose of Well: Domestic (Domestic Irrigation Municipal, Industrial, Other)	White sand	86	215-301


Information upon completion of well:

- (1) Diameter 2 inches.
- (2) Total Depth 301 feet.
- (3) Water Level 126 feet below top of ground.
- (4) Cased to 296, Size 2"
- (5) Screen: Size 2" 1/2 slot, Length 5 ft.
- (6) Were any formations sealed against pollution?
 yes, no.

If YES depth of formation _____

Why _____

Drillers Remarks: _____

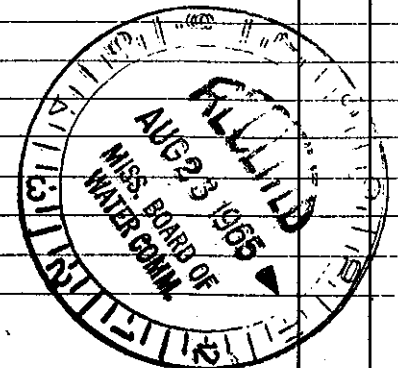

(Use Back Side)

Well No.

Retain this copy for your office files.