

KEMPER
R 28
5-2-79


MISSISSIPPI
 BOARD OF WATER COMMISSIONERS
 416 North State Street
 Jackson, Mississippi 39201

CODED

WATER WELL DRILLERS LOG

5-2-79 date well completed
 McDONALD + HILL film name
 KEMPER county well located

LANDOWNER:	description of formations encountered	from	to
CHARLES REID	Gumbo Clay	0	18
Rt #1, Bailey, MS (mailing address)	LIGNITE SHALE	18	45
WELL LOCATION: sec. 26 T 9 N R 15 E 1/2 miles EAST of PRISMATIC (distance) (direction) (nearest town)	SHALE	45	68
WELL PURPOSE: (home) Irrigation, municipal, industrial	ROCKS ST SHALE	68	94
WELL COMPLETION DATA:	SANDY SHALE	94	126
(1) diameter (inches) 4"	ROCK	126	127
(2) total depth (feet) 160'	SANDY SHALE	127	149
(3) static water level (feet) 125' below top of ground.	FINE SAND	149	160
(4) casing PVC 60' (material) (depth) 4" (size) if telescope see back.			
(5) screen (length) (depth to top) (size) (material)			
(6) pump 1 JET 10 (HP) (yield gpm) ELECTRIC (type power)			
(7) electric log (yes or no) (organization running log)			
(8) how well bottom plugged OPEN			
DRILLERS REMARKS:			

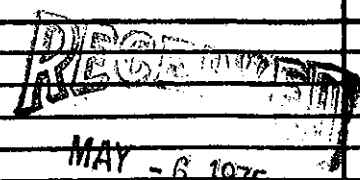

MISS. BD. OF WATER COMM