

~~Ladderdale~~
~~CH~~
~~9/66~~

This log is typical
of Kemper county ENB

MISSISSIPPI BOARD OF WATER COMMISSIONERS

S8

WATER WELL DRILLERS LOG

CODED
KEMPER


Date: 9-23, 1966, Driller: M^c Donald Hill Inc County: LAUDERDALE
(When well drilled) (Name) (Where well is located)

(1) Owner of Land	Description & Color of Materials Sand, Clay, Red Clay, Shell, etc.	Thick- ness Feet	Depth Feet
<u>WILLIAM LEGGETT</u> (Name)	<u>CLAY</u>	<u>18</u>	<u>18</u>
<u>R# 3 DEKALB</u> (Address)	<u>SAND</u>	<u>54</u>	<u>72</u>
(2) Location: <u>SW 1/4, NE 1/4 Sec 31 9 T16R E</u>			
<u>6</u> miles <u>N EAST</u> of <u>NAAS NAVY BASE</u> (distance) (direction) (Nearest Town)			
(3) Topography: <u>X</u> (Hilly) (Flat) (Level)			
(4) Purpose of Well: <u>DOMESTIC</u> (Domestic Irrigation Municipal, Industrial, Other)			

Information upon completion of well:

- (1) Diameter 2" WELL inches.
(2) Total Depth 72' feet.
(3) Water Level 22 feet below top of ground.
(4) Cased to 65', Size 2"
(5) Screen: Size 2", Length 5'
(6) Were any formations sealed against pollution?
_____ yes, X no.

If YES depth of formation _____
Why _____
Drillers Remarks: _____
Yield in gpm: 20
Size pump: _____
Type power: _____

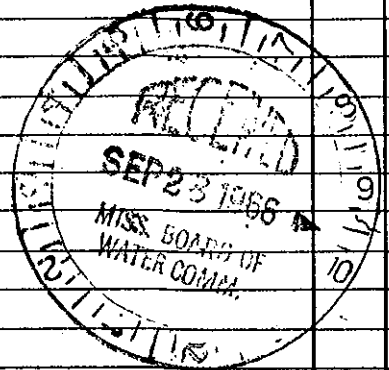

Mail this copy to Board of Water Commissioners 429 Miss. St. Jackson, Miss.