

KEMPER MISSISSIPPI BOARD OF WATER COMMISSIONERS

T 1 CODED

12-15-64 WATER WELL DRILLERS LOG

Date: 12-15, 1964, Driller: Bob Williamson County Kemper
 (Name)

(1) Owner of Land: <u>John Baylor</u> <small>(Name)</small>	Description & Color of Materials Sand, Clay, Red Clay, Shell, etc.	Thick- ness Feet	Depth Feet
<u>Renton #3, Oskaola</u> <small>(Address)</small>	<u>Red clay</u>	<u>5</u>	<u>1-5</u>
(2) Location: <u>1/4, 1/4, Sec. 33 T9 R17E</u>	<u>Red sand</u>	<u>15</u>	<u>5-20</u>
<u>20 miles North</u> of <u>Merida</u> <small>(distance) (direction) (Nearest Town)</small>	<u>Blue clay</u>	<u>15</u>	<u>30-35</u>
(3) Topography: <u>Hilly</u> <small>(Hilly) (Flat) (Level)</small>	<u>Yellow sand</u>	<u>40</u>	<u>35-75</u>
(4) Purpose of Well: <u>Domestic</u> <small>(Domestic Irrigation Municipal, Industrial, Other)</small>	<u>Blue clay</u>	<u>10</u>	<u>75-85</u>
	<u>White sand</u>	<u>7.2</u>	<u>85-157</u>
	<u>No water returned</u>	<u>2.1</u>	<u>157-178</u>


Information upon completion of well:

- (1) Diameter 2 inches.
- (2) Total Depth 178 feet.
- (3) Water Level 108 feet below top of ground.
- (4) Cased to 173, Size 2"
- (5) Screen: Size 2" 15 slot, Length 5'
- (6) Were any formations sealed against pollution?
 yes, no.

If YES depth of formation _____

Why _____

Remarks: _____

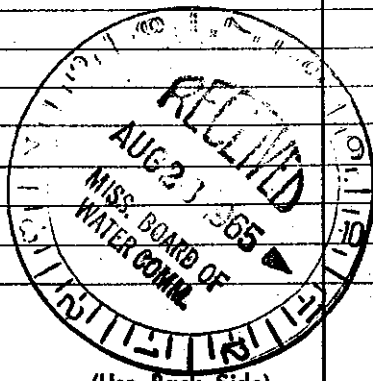

(Use Back Side)

Well No. _____

Mail this copy to Board of Water Commissioners 429 Miss. St. Jackson, Miss