


KEMPER MISSISSIPPI BOARD OF WATER COMMISSIONERS
CODED

U 2
7-9-63

WATER WELL DRILLERS LOG

Date: 7-9, 1963, Driller: Mc Donald & Hill County Kemper
(Name)

	Description & Color of Materials Sand, Clay, Red Clay, Shell, etc.	Thick- ness Feet	Depth Feet
(1) Owner of Land: <u>Gregg Moore</u> (Name)	<u>Clay</u>	<u>0</u>	<u>7</u>
<u>Sanderdale</u> (Address)	<u>Sand</u>	<u>7</u>	<u>55</u>
(2) Location: <u>34 918</u> 1/4, 1/4, Sec. T R	<u>Shale</u>	<u>55</u>	<u>62</u>
<u>7</u> miles <u>NE</u> of <u>Sanderdale</u> (distance) (direction) (Nearest Town)	<u>Shale w/ shells - broken</u>	<u>62</u>	<u>76</u>
(3) Topography: <u>Hilly</u> (Hilly) (Flat) (Level)	<u>Sand</u>	<u>76</u>	<u>83</u>
(4) Purpose of Well: <u>Domestic</u> (Domestic Irrigation Municipal, Industrial, Other)	<u>Shale</u>	<u>87</u>	<u>85</u>

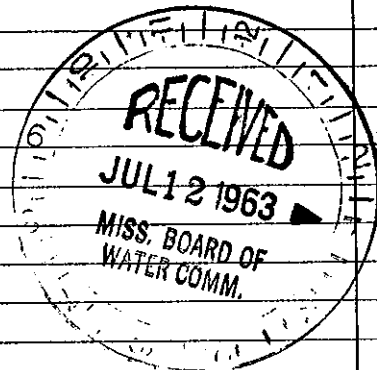

Information upon completion of well:

- (1) Diameter 3 1/4 inches.
- (2) Total Depth 85 feet.
- (3) Water Level 79 feet below top of ground.
- (4) Cased to 79, Size 2"
- (5) Screen: Size 2", Length 5'
- (6) Were any formations sealed against pollution?
_____ yes, _____ no.

If YES depth of formation _____

Why _____

Drillers Remarks: _____

Well No.

(Use Back Side)

Mail this copy to Board of Water Commissioners, 429 Miss. St. Jackson, Miss.