

LAFAY.
A 6
10-27-61

WATER WELL DRILLERS

C. Paul

5

Date: 10-27, 1961, Driller: J. B. Cain County PANOLA

(Name)

(1) Owner of Land:	Description & Color of Materials Sand, Clay, Red Clay, Shell, etc.	Thick- ness Feet	Depth Feet
FRANCIS, WILLIAMS (Name)	<i>Sand</i>	0	59
COMO MISS (Address)	<i>edge of</i>	59	80
	<i>sand</i>	80	100

(2) Location: 1/4, 1/4, Sec. 26 T 6 R 5

20 miles East of Como
(distance) (direction) (Nearest Town)

(3) Topography: (Hilly) (Flat) (Level)

(4) Purpose of Well: HOME
(Domestic Irrigation
Municipal, Industrial, Other)

Information upon completion of well:


- (1) Diameter 2 inches.
- (2) Total Depth 100 feet.
- (3) Water Level 67 feet below top of ground.
- (4) Cased to 100, Size 2"
- (5) Screen: Size 1/4, Length 6
- (6) Were any formations sealed against pollution?
_____ yes, no no.

If YES depth of formation _____

Why _____
Drill - - - - - Remarks: Sandy Dont

No T. R. or Sec.

of land

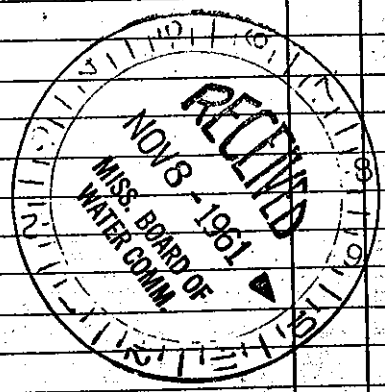

(Use Back Side)

Mail this copy to Board of Water Commissioners 429 Miss. St. Jackson, Miss.

Well No. 5