

LAFAY, MISSISSIPPI BOARD OF WATER COMMISSIONERS

A 7
8-2-63

WATER WELL DRILLERS *Coled*

18

Date: 8-2, 1963, Driller: JBCAIA County: Panola

(Name)

(1) Owner of Land:	Description & Color of Materials Sand, Clay, Red Clay, Shell, etc.	Thick- ness Feet	Depth Feet
<u>Baltis Church</u> (Name) <u>Hamon Town Miss</u> (Address)	<u>Clay</u> <u>Sand</u>	<u>0</u> <u>30</u>	<u>30</u> <u>95</u>
(2) Location: <u>1/4</u> , <u>1/4</u> , Sec. <u>29 T. 6 R. 4</u> ,			
<u>0</u> miles <u>Hamon</u> , of <u>Town</u> (distance) (direction) (Nearest Town)			
(3) Topography: <input checked="" type="checkbox"/> (Hilly) <input type="checkbox"/> (Flat) <input type="checkbox"/> (Level)			
(4) Purpose of Well: <u>Church</u> (Domestic Irrigation Municipal, Industrial, Other)			


Information upon completion of well:

- (1) Diameter 2" inches.
- (2) Total Depth 95 feet.
- (3) Water Level 75 feet below top of ground.
- (4) Cased to 95, Size 2"
- (5) Screen, Size 2", Length 5
Plastic well
- (6) Were any formations sealed against pollution?
_____ yes, _____ no.

If YES depth of formation _____

Why _____

Drillers Remarks: _____

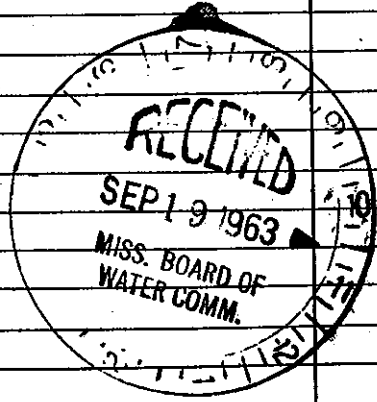

Well No.

(Use Back Side)