

LA FAY
A 8

MISSISSIPPI BOARD OF WATER

WATER WELL DRILLERS LOG

1-1-63

Date: 1-1, 1963, Driller: B. CAIN County: _____
(Name)

[Handwritten signature]

		Description & Color of Materials Sand, Clay, Red Clay, Shell, etc.	Thick- ness Feet	Depth Feet
(1) Owner of Land:	<u>Melton J. Guthrie</u> (Name)			
	<u>Memphis Tenn</u> (Address)	<u>Brook Cl</u>	<u>0</u>	<u>20</u>
(2) Location:	<u>1/4, 1/4, Sec. 35 T. 7 R. 5</u>	<u>Sand</u>	<u>20</u>	<u>100</u>
	<u>1.5 miles NW of Oxford</u> (distance) (direction) (Nearest Town)	<u>Blue Clay</u>	<u>100</u>	<u>120</u>
(3) Topography:	<input checked="" type="checkbox"/> (Hilly) <input type="checkbox"/> (Flat) <input type="checkbox"/> (Level)	<u>Water Sand</u>	<u>120</u>	<u>150</u>
(4) Purpose of Well:	<u>Cabin</u> (Domestic Irrigation Municipal, Industrial, Other)			

[Large handwritten signature]


Information upon completion of well:

- (1) Diameter 2 inches.
- (2) Total Depth 150 feet.
- (3) Water Level 60 feet below top of ground.
- (4) Cased to 150, Size 2"
- (5) Screen: Size 1/4, Length 6 FT
- (6) Were any formations sealed against pollution?
_____ yes, _____ no.

If YES depth of formation _____

Why _____

Drillers Remarks: _____

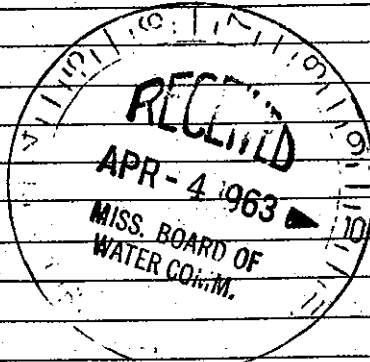

(Use Back Side)

Well No. _____

Mail this copy to Board of Water Commissioners 429 Miss. St. Jackson, Miss