

L.A.F.
All
2-25-63

MISSISSIPPI BOARD OF WATER COMMISSIONERS

WATER WELL DRILLERS LOG

Date: 2/25, 1963, Driller: Ellen H. Hardwood County Lafayette
(Name)

(1) Owner of Land: Jack Pettis
(Name)
Oxford, Miss - RFD #2
(Address)

(2) Location: 1/4, 1/4, Sec 25 T2R4W
8 miles West of Oxford
(distance) (direction) (Nearest Town)

(3) Topography: Hilly
(Hilly) (Flat) (Level)

(4) Purpose of Well: Domestic
(Domestic Irrigation
Municipal, Industrial, Other)

Description & Color of Materials Sand, Clay, Red Clay Shell, etc.	Thick- ness Feet	Depth Feet
<u>Red Clay -</u>	<u>25</u>	<u>25</u>
<u>SAND -</u>	<u>25</u>	<u>150</u>
<u>Clay</u>	<u>2</u>	<u>152</u>

[Handwritten signature]

Information upon completion of well:

(1) Diameter 4 inches.

(2) Total Depth 152 feet.

(3) Water Level 90 feet below top of ground.

(4) Cased to No, Size No


(5) Screen: Size 4", Length 8'

(6) Were any formations sealed against pollution?
No yes, x no.

If YES depth of formation _____

Why _____

Drillers Remarks: _____

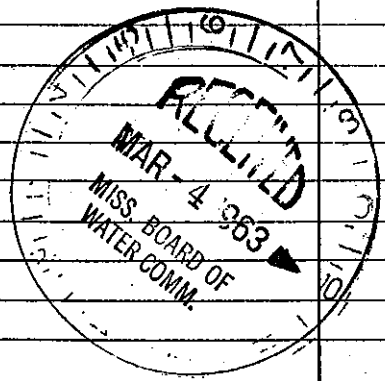

Well No. _____

(Use Back Side)

Retain this copy for your office files.