

# State Well Report

Part 1

Mississippi Department of Environmental Quality  
Office of Land and Water Resources  
P.O. Box 10631  
Jackson, MS 39289-0631  
(601)961-5210  
(601)354-6938 (fax)

For Office Use Only:

Aquifer: \_\_\_\_\_  
Well #: A-59  
L. S. Elevation: \_\_\_\_\_  
E-log #: \_\_\_\_\_

County: Lafayette  
Permit #: \_\_\_\_\_  
Driller: Leeper Drilling  
Date drilling completed: 1-27-07

State Law requires that this report be prepared by the driller in detail and filed with the Department within 30 days of completion of drilling of the well.

Well Owner Information	Well Location
Owner Name: <u>Ronald Webb</u>	Latitude: _____ Longitude: _____
Mailing Address: <u>567 CR 313</u>	Method of Lat/Long (circle one): Conventional Survey, USGS quad, Hand-held GPS, Survey-grade GPS
<u>Oxford MS 38655</u> City State Zip Code	<u>1/4 1/4 Sec 21 Twn 75 Rng 4W</u>
Telephone No. <u>(601) 816-9524</u>	Distance <u>8</u> Miles Direction <u>NW</u> of Nearest Town <u>Oxford</u>

**Well Data**

Purpose of Well (circle one) Home Industrial Public Supply Irrigation Fish Culture Other: \_\_\_\_\_

Date well drilling started: 1-27-07 Date well drilling completed: 1-29-07

If flowing, method of flow regulation: Valve \_\_\_\_\_ Other (describe) \_\_\_\_\_

Static Water Level: 90 feet above or below (circle one) land surface Date measured: 1-29-07

Method of Measurement (circle one) steel tape electric tape air line other: \_\_\_\_\_

Hole depth: 190 ft Well depth: 190 ft Well grouted to a depth of 10 feet

Type of grout (circle one): Cement Bentonite Mix

Casing length: 175 feet Casing diameter: 4 inches Type of casing: PVC

Screen length: 15 feet Screen diameter: 4 inches Type of screen: PVC

Screen slot size: .010 inches Setting depth: From 175 feet to 190 feet

Type of completion (circle all applicable): Gravel packed Underreamed Telescoped Open hole Natural Development  
Other (describe): \_\_\_\_\_

Top of lap pipe or reduction in casing: \_\_\_\_\_ feet. If telescoped or more than one screen, describe on back of page

Logs run (circle all applicable): No log run Electric Gamma Ray Density Sonic Neutron Other: \_\_\_\_\_

Name of organization running log(s): \_\_\_\_\_

I certify that the well was drilled, constructed, and completed in accordance with all applicable requirements of the Mississippi Department of Environmental Quality and/or the Mississippi Department of Health regulations and state laws.

Leeper Drilling # 0079  
Print Name of Water Well Contractor and License No.

[Signature]  
Signature of Water Well Contractor

RECEIVED  
FEB 10 2007  
BY: OLWR



# STATE WELL REPORT

## Part 2

**Pump Installer's Completion Report**  
 Mississippi Department of Environmental Quality  
 Office of Land and Water Resources  
 P.O. Box 10631  
 Jackson, MS 39289-0631  
 (601)961-5210  
 (601)354-6938 (fax)

County: LAFAYETTE  
 Permit #: \_\_\_\_\_  
 Driller: LEEPER Drilling  
 Date completed: 1-29-07

For Office Use Only:

Aquifer: \_\_\_\_\_  
 Well #: A-59  
 Elevation: \_\_\_\_\_

**This report should be prepared by the pump installer in detail and filed with the Department within 30 days of the installation of pump.**

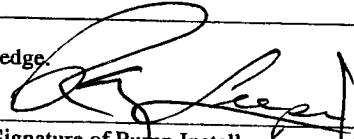
Well Owner Information	Well Location
Owner Name: <u>Ronald Webb</u> Mailing Address: <u>567 CA 313</u> <u>Oxford, MS 38655</u> City State Zip Code Telephone No. <u>662 816-9524</u>	Latitude: _____ Longitude: _____ Method of Lat/Long (circle one): Conventional Survey, USGS quad, Hand-held GPS, Survey-grade GPS _____ 1/4 _____ 1/4 Sec <u>21</u> Twn <u>75</u> Rng <u>4W</u> Distance Direction Nearest Town <u>8</u> Miles <u>NW</u> of <u>Oxford</u>

Pump Type Circle one	Power Type Circle one
Air Lift Jet <u>Submersible</u> Bucket Piston Turbine Centrifugal Rotary Flowing Well Other (specify): _____ Date Pump Installed: <u>1-29-07</u> Rated Pump Capacity: <u>10</u> Gallons Per Minute	Diesel Engine Gasoline Engine Natural Gas <u>Electric Motor</u> Hand Tractor PTO Windmill Other (specify): _____ Horse Power Rating of Motor: <u>3/4 HP</u> Setting Depth: <u>140</u> feet Number of Stages: <u>11</u>

Pump Test Data	Method of Measuring Water Level Circle one
Date Well Tested: <u>1-29-07</u> Static Water Level (A): <u>90</u> Feet Below Land Surface Pumping Water Level (B): _____ Feet Below Land Surface Drawdown [(B) - (A)]: _____ Feet Below Land Surface Test Pumping Rate: _____ Gallons Per Minute Duration of Pump Test (minimum 4 hours): _____ hours	Air Line Electric Measuring Line <u>Steel Tape</u> Other (specify): _____ For flowing well, measured shut in head: _____ feet Well yielded _____ GPM with a drawdown of _____ feet after _____ hours of pumping

I HEREBY CERTIFY that the above statements are true to the best of my knowledge.

Leeper Drilling # 0079  
 Print Name of Pump Installer and License No. (if applicable)

  
 Signature of Pump Installer

**RECEIVED**  
 FEB 16 2007  
 BY: OLWR