

LAFAYETTE
 A 2006
 8/20/77

MISSISSIPPI
 BOARD OF WATER COMMISSIONERS
 416 North State Street
 Jackson, Mississippi 39201

WATER WELL DRILLERS LOG

8-20-1977 *Leaper* *Lafayette*
 date well completed firm name county well located

LANDOWNER:
Ken Ash
Opford, Miss
 (mailing address)

description of formations encountered	from	to
<i>Red sand & Rock</i>	<i>0</i>	<i>20</i>
<i>Red sand & Rock</i>	<i>20</i>	<i>60</i>
<i>Blue Clay</i>	<i>60</i>	<i>100</i>
<i>Blue Clay & Rock</i>	<i>100</i>	<i>140</i>
<i>Sand</i>	<i>140</i>	<i>181</i>
		<i>1612</i>


WELL LOCATION:
 sec. *6* T. *7* R. *4*
2 miles *SW* of *Colleyville*
 (distance) (direction) (nearest town)

WELL PURPOSE: *home*
 (home, irrigation, municipal, industrial)

- WELL COMPLETION DATA:
- (1) diameter (inches) *4*
 - (2) total depth (feet) *181*
 - (3) static water level (feet) *80* ^{below} _{above} top of ground.
 - (4) casing *Plastic 171'*
 (material) (depth)
 (size) If telescope see back.
 - (5) screen *10*, *171*
 (length) (depth to top)
4, *Plastic*
 (size) (material)
 - (6) pump *3/4*, *10*
 (HP) (yield gpm)
Elect
 (type power)
 - (7) electric log (yes or no)

(organization running log)
 (8) how well bottom plugged *Value*

DRILLERS REMARKS:

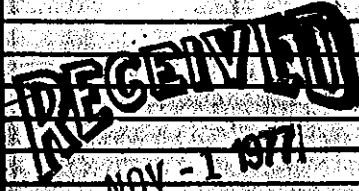

MISS. BOARD OF WATER COMMISSIONERS