

Lafayette
A 2018
6/29 Aug 79

MISSISSIPPI
 BOARD OF WATER COMMISSIONERS
 416 North State Street
 Jackson, Mississippi 39201

WATER WELL DRILLERS LOG

6/29 Aug 79 *DEEPER* *Lafayette*

date well completed firm name county well located

LANDOWNER:

Delaine Hunter
Clear Creek Rd
Oxford (mailing address) MS

description of formations encountered from to

top clay 0 20
Red Sand 20 140
White Sand 140 190

WELL LOCATION:

sec. *29* T. *7* N. R. *4* E.
8 miles *NW* of *Oxford*
 (distance) (direction) (nearest town)

WELL PURPOSE:

(home, irrigation, municipal, industrial)


WELL COMPLETION DATA:

- (1) diameter (inches) *4 1/8*
- (2) total depth (feet) *190*
- (3) static water level (feet) *120* ^{below} top of ground
- (4) casing (material) *PVC* (depth) *180*
 (size) if telescope see back.
- (5) screen (length) *10'* (depth to top) *180*
 (size) (material) *PVC*
- (6) pump (HP) *1* (yield gpm) *10*
 (type power)
- (7) electric log *Yes* (yes or no)
- (organization running log)
- (8) how well bottom plugged *Cap*

DEPT. OF NATURAL RESOURCES
 BUREAU OF LAND & WATER RESOURCES

FEB 24 1980

RECEIVED

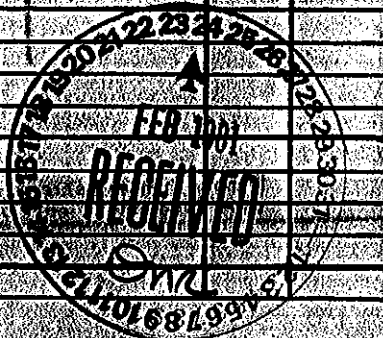

DRILLERS REMARKS: