

MISSISSIPPI DEPARTMENT OF NATURAL RESOURCES

Bureau of Land and Water Resources

Southport Mall

P.O. Box 10631

Jackson, Mississippi 39209

WATER WELL DRILLERS LOG

LAFAYETTE
A 7019
5/20/81
5/20

19 81 Hills Well Co. Lafayette
date well completed firm name county/well located

LANDOWNER	description of formations encountered	from	to
James Simmerman Rt. 1 Box 148 Congo, Ms. (mailing address)	Red sand & gravel	0	66
	White clay & sand	60	125
	White sand	125	155

WELL LOCATION:
sec. 2 T. 7 N. R. 5 E.
1 miles S of Slonville
(distance) (direction) (nearest town)

WELL PURPOSE: Home
(home, irrigation, municipal, industrial)

WELL COMPLETION DATA:

(1) diameter (inches) 4"

(2) total depth (feet) 155

(3) static water level (feet) 100 below top of ground

(4) casing PVC 155'
(material) (depth)

(size) if telescope see back.

(5) screen 10' 14" x 2"
(length) (depth to top)


(size) (material) PVC

(6) pump 1/2 HP 10 (yield gpm)
220V (type power)

(7) electric log No (yes or no)

(organization running log)

(8) how well bottom plugged Cap

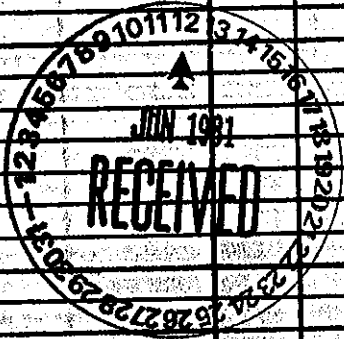

DRILLERS REMARKS: