


MS-GW-1

Lafayette
B9
3-67

MISSISSIPPI BOARD OF WATER COMMISSIONERS
416 North State Street
Jackson, Mississippi 39201
383
WATER WELL DRILLING

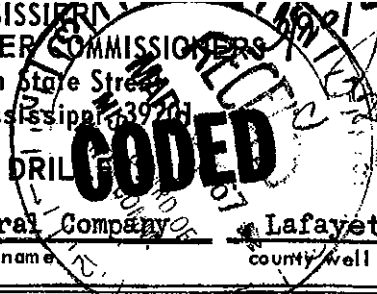

March 10, 1967 Layne-Central Company Lafayette
date well completed firm name county well located

LANDOWNER, Abbeville Water Association, Inc.	description of formations encountered	from	to
Abbeville, Mississippi (mailing address)	Red sandy clay	0	38
	Sand & strks, white clay	38	40
	Coarse sand	40	79
	Coarse sand, strks. white clay	79	89
	Sand	89	108
	Clay	108	155
	Shale	155	183
	Shale strks. white clay	183	226
	Shale	226	293
	Hard clay	293	340
	Clay	340	358
	Sandy shale	358	376
	Shale	376	385
	Sandy shale	385	396
	Fine gr. sand	396	462
	Sand	462	508
	Fine sand, shale strks.	508	520
	Shale	520	574

LANDOWNER, Abbeville Water Association, Inc.

Abbeville, Mississippi
(mailing address)

WELL LOCATION:



_____ miles at Abbeville
(distance) (direction) (nearest town)

WELL PURPOSE: municipal
(home, irrigation, municipal, industrial)

WELL COMPLETION DATA:

- (1) diameter (inches) 8 x 6
- (2) total depth (feet) 507' 7"
- (3) static water level (feet) 150' below top of ground.
- (4) casing steel 169' of 6" (material) (depth)
20' of 6" (material) (depth)
469' of 8" (size) if telescope see back.
- (5) screen 30' 2" (length) 499' 3" (depth to top)
6" (size) Stainless Steel (material)
- (6) pump 15 (HP) 108 @ 60 lbs. (yield gpm)
Etc. (type power)
- (7) electric log no (yes or no)
- (8) how well bottom plugged Slugs & shot.

DRILLERS REMARKS: