

WATER WELL DRILLERS LOG

ELLIOTT HARDWARE COMPANY

Date: 4/22, 1961, Driller: OXFORD, MISSISSIPPI County Lafayette  
(Name)


- (1) Owner of Land: J.W. Ford  
(Name)  
Abbeville, Miss  
(Address)
- (2) Location: 1/4, NE 1/4, Sec. 3 T75R36E  
0 miles NE (direction) of Abbeville, Miss. (Nearest Town)
- (3) Topography: Hilly  
(Hilly) (Flat) (Level)
- (4) Purpose of Well: Domestic  
(Domestic Irrigation, Municipal, Industrial, Other)

Description & Color of Materials Sand, Clay, Red Clay, Shell, etc.	Thick- ness Feet	Depth Feet
Clay	15	15
Red Clay	7	22
Sand & Clay -	30	52
Pink clay -	2	54
Blue, Black & Green Clay	137	191
Blue	69	260
Hard fine sand	80	340
Soft sand -	160	500

Information upon completion of well:

- (1) Diameter 6 inches.
- (2) Total Depth 500 feet.
- (3) Water Level 80 feet below top of ground.
- (4) Cased to 200, Size 6"
- (5) Screen: Size NONE, Length —
- (6) Were any formations sealed against pollution?  
\_\_\_\_\_ yes, \_\_\_\_\_ no.

Copied

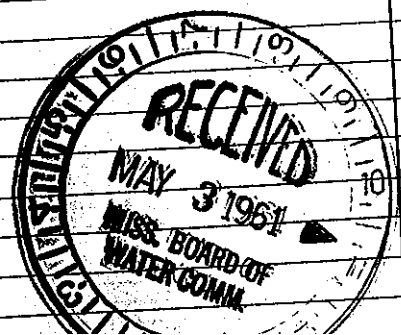

If YES depth of formation \_\_\_\_\_

Why \_\_\_\_\_

Drillers Remarks: \_\_\_\_\_