

LAF.

MISSISSIPPI BOARD OF WATER COMMISSIONERS

WATER WELL DRILLERS LOG

B 19
3-29-62Date: 3/29, 1962, Driller: ELLIOTT HARDWARE COMPANY, County: Lafayette
(Name) MISSISSIPPI

		Description & Color of Materials Sand, Clay, Red Clay, Shell, etc.	Thick- ness Feet	Depth Feet
(1) Owner of Land: <u>M. Clyde Bonds</u> (Name) <u>Alberville, Miss.</u> (Address)		<u>Sand + Clay</u>	<u>118</u>	<u>118</u>
(2) Location: <u>1/4, 1/4, Sec. 3 T25R31W</u>		<u>BLUE Mud clay</u>	<u>177</u>	<u>285</u>
<u>0</u> miles <u>South East</u> , of <u>Alberville</u> (distance) (direction) (Nearest Town)		<u>Hard Black Clay and</u>	<u>155</u>	<u>440</u>
(3) Topography: <u>Hilly</u> (Hilly) (Flat) (Level)		<u>Mica Sand-</u>	<u>22</u>	<u>462</u>
(4) Purpose of Well: <u>Domestic</u> (Domestic Irrigation Municipal, Industrial, Other)		<u>Soft Clay + Sand</u>		

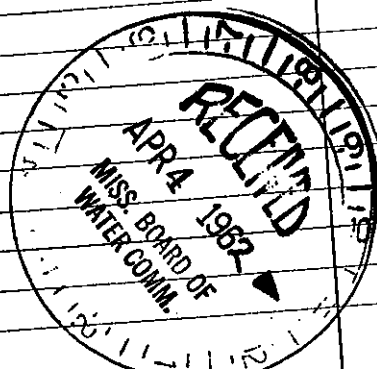
Information upon completion of well:

- (1) Diameter 4 inches.
- (2) Total Depth 462 feet.
- (3) Water Level 148 feet below top of ground.
- (4) Cased to 300', Size 4"
- (5) Screen: Size 0, Length _____
- (6) Were any formations sealed against pollution?
_____ yes, _____ no.

If YES depth of formation _____

Why _____

Drillers Remarks: _____

Cased

Well