
State	e Well Report	<b>-</b>
County:Afayette	Part 1	For Office Use Only:
Permit #	ment of Environmental Quality	Aquifer:
	nd and Water Resources O. Box 10631	Well #: B-67
Jackso	n, MS 39289-0631	L. S. Elevation:
	501)961-5210 1)354-6938 (fax)	
		E-log #:
State Law requires that this report be prepared by 30 days of completion of drilling of the well.	the driller in detail and filed w	ith the Department within
Well Owner Information	Well	Location
Owner Name Chyd Ramsey Construct	Latitude:	_" Longitude:^
Mailing Address: 465 CR 215	Method of Lat/Long (circle or	
	USGS quad, Hand-held	GPS, Survey-grade GPS
Abbeville MS 38601 City / State Zip Code	¼ ¼ Sec_ Z <	Twn 75 Rng 3W
Telephone No. (662)		Nearest Town of <u>0 × for </u>
W	/ell Data	)
Purpose of Well (circle one) Home Industrial Public Supp	· · · · ·	
Date well drilling started: $3 \cdot 1 - \circ 7$ D	ly Irrigation Fish Culture	Other:
If flowing, method of flow regulation: Valve Othe	are wen unning completed:	
Static Water Level: <u>90</u> feet above or below (circle or	ic) land surface Date measured	3-2-07
Method of Measurement (circle one) steel tape electric t	aDC sir line other	
Hole depth: 160 ft Well depth: 160 ft	Well grouted to a depth of	/U feet
Type of grout (circle one): Cement Bentonite (M	ix)	
Casing length: 145 feet Casing diameter: 4	inches Type of casing:	PVC
Screen length: <u>1.5</u> feet Screen diameter: <u>4</u>	inches Type of screen:	Puc
Screen slot size:	<u>145</u> feet to 16	
Type of completion (circle all applicable): Gravel packed Und	erreamed Telescoped Open h	
Other (describe):		_
Top of lap pipe or reduction in casing:feet. If	telescoped or more than one scree	n describe on back - f
Logs run (circle all applicable): No log run Electric Gamma Re	y Density Sonic Neutron O	ther:
Name of organization maning log(a).		1
I certify that the well was drilled, constructed, and completed in Department of Environmental Quality and/or the Ministerior in D	accordance with all applicable re	quirements of the Mississinni
2 County and/or the Mississippi D	epartment of Health regulations of	nd state laws.
Leeper Drilling # 0	079	Freeze
Print Name of Water Well Contractor and License No.	Signature of W	Vater Well BEAD FUVED
		MAR 2 3 2007
		BY: OLWR

If well telescopes please sketch below and show depths.

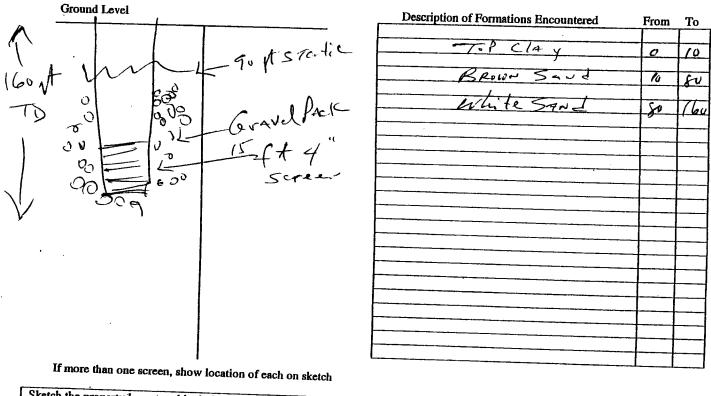

B-67

Sketch the property layout and include the following: 1) the well location; 2) any permanent structures on the property that may aid in locating the well; 3) any roads, power lines, or other items that may aid in locating the property, and the well; DE Well ME DRIVE 215 CR Ramsey Construction Landowner Name: Signature of Water Well Contractor ( RECEIVED MAR 2 9 2007 BY: OLWB

	STATE WELL REPORT		
County:yette	Part 2	ſ <u></u>	
	Pump Installer's Completion Report	For Office Use Only:	
Permit #:	Mississippi Department of Environmental Quality Office of Land and Water Resources	Aquifer:	
Driller: Leeper Drilling	P.O. Box 10631		
Date completed: $3/2/07$	Jackson, MS 39289-0631	Well #: <u>B-67</u>	
	(601)961-5210 (601)354-6938 (fax)	Elevation:	
This report should be prepared by the			
installation of pump.	nump installer in detail and filed with the Depart	ment within 30 days of the	
I I I I I I I I I I I I I I I I I I I			
Owner Name: Child KAMSzy	Construction Latitude:	Y	
Mailing Address: 456 CR 2	Construction Latitude:	Longitude:	
	Method of Lat/Long (circle	e one): Conventional Survey,	
A11 11	USGS quad, H	and-held GPS, Survey-grade GPS	
Abbeville / City State/	MS 38601		
City State/		24 Twn 75 Rng 34	
Telephone No. (662) 234 - 538	Distance Direction	i toureat fown	
		Miles Of UX-ford	
Pump Type Circle one		Power Type	
Airlift		Circle one	
Air Lift Jet Su	bmersible Diesel Engine Gaso	line Engine Natural Gas	
Bucket Piston Tu	urbine Pi		
Centrifugal	Elecule Motor Hand	I 'Tractor PTC	
	owing Well Windmill Other	r (specify):	
Other (specify):		n:/HP	
Date Pump Installed: 7/6 7			
Rated Pump Capacity: (U Gall	Setting Depth: 140	feet	
Gall	ons Per Minute Number of Stages:	4	
Pump Test Data			
Date Well Tested: $\frac{3/2}{0}$	Method of Me	easuring Water Level	
	(·	Circle one	
Static Water Level (A):Feet Below	Air Line Electric Mer	asuring Line Steel Tape	
Pumping Water Level (B):Feet Below	Land Surface Other (specify):		
Providence (27)Feet Below	Land Surface		
Drawdown [(B) – (A)]:Feet Below	V Land Surface   For flowing well, measured ab	ut in head:fect	
Test Pumping Rate:Gallo	ns Per Minute	feçt	
Duration of Pump Test (minimum 4 hours):			
+ 100(8)	hoursfeet after	hours of pumping	
HEREBY CERTIFY that the above statements a	the true to the best of		
Leeper Drilling TT	-0079		
Print Name of Pump Installer and License No. (if a		(iepe)	
	ipplicable) Signature of Pump Inst	staller PETEIM	
	•	1 DAVE 1	
		MAR 2 9 20	