

Bureau of Land and Water Resources
 Southport Mall
 P.O. Box 10631
 Jackson, Mississippi 39209
WATER WELL DRILLERS LOG

B 3031

10/2/85
 date well completed 19

Wilson Well Co. Inc.
 firm name

Leflore
 county/well located


LANDOWNER: Richard Laughter

3046 S. Beadette Rd.

Memphis, Tenn.
 (mailing address)

description of formations encountered	from	to
<u>red clay - white sand white clay</u>	<u>0</u>	<u>15</u>
<u>white sand - white clay</u>	<u>15</u>	<u>30</u>
<u>white sand - white clay</u>	<u>30</u>	<u>75</u>
<u>white sand -</u>	<u>75</u>	<u>150</u>

WELL LOCATION:

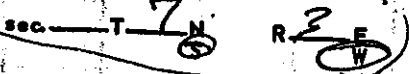

sec. 7 N 2 E
 (distance) miles (direction) of Oshtemo
 (nearest town)

WELL PURPOSE: Home
 (home, irrigation, municipal, industrial)

WELL COMPLETION DATA:

- (1) diameter (inches) 4"
- (2) total depth (feet) 150'
- (3) static water level (feet) 85' ^{below} _{above} top of ground.
- (4) casing P.V.C. 130'
 (material) (depth)
4"
 (size) If telescope see back.
- (5) screen 20'
 (length) (depth to top)
4" P.V.C.
 (size) (material)
- (6) pump 1 15
 (HP) (yield gpm)
Elect.
 (type power)
- (7) electric log NO
 (yes or no)
 (organization running log)
- (8) how well bottom plugged 4" pipe

DRILLERS REMARKS:

RECEIVED
 OCT 21 1985

Department of Natural Resources
 Bureau of Land & Water Resources

10/16/85