
	State Well Report	For Office Use Only
County: 64-fayette	Part 1 Mississippi Department of Environmental Quality	
Permit #:	Office of Land and Water Resources	Aquifer:
Driller: Leeper Drilling	P.O. Box 10631	Well #: <u>C-11</u>
Date drilling completed:	Jackson, MS 39289-0631	L. S. Elevation:
	(601)961-5210 (601)354-6938 (fax)	E-log #:
ov days of completion of arming	ort be prepared by the driller in detail and filed v g of the well.	L
Well Owner Informa	ation Wel	l Location
Owner Name Dwn. ~ Acker		_" Longitude:'
Mailing Address: 25 BAY 5	Method of Lat/Long (circle of	ne): Conventional Survey,
	USGS quad, Hand-held	I GPS, Survey-grade GPS
City Stat	1) te Zip Code	2_Twn_75_Rng_2
Telephone No. (662) \$16-0157	U Distance Direction	Nearest Town of
	Well Data	
Purpose of Well (circle one) Home	ustrial Public Supply Irrigation Fish Culture	
I apple of white (encirc one) Home Indi	ustrial Public Supply Irrigation Fish Culture	Other: Deer Cam
Date well drilling started:	Date well drilling completed:S	-10-00
	ve Other (describe)	
	ove of below)(circle one) land surface Date measured:	
	Date measured:	5 -11-05-
Mad at car		
Method of Measurement (circle one) ste	cel tape electric tape air line other:	
Mad at car	eel tape electric tape air line other:	
Method of Measurement (circle one) ste Hole depth: Well dep Type of grout (circle one): Cement	eel tape electric tape air line other: oth: Well grouted to a depth of Bentonite Mix	/Ofeet
Method of Measurement (circle one) ste Hole depth: Well dep Type of grout (circle one): Cement Casing length: feet Casing Screen length: feet Screen	eel tape electric tape air line other: oth: Well grouted to a depth of Bentonite Mix g diameter: inches Type of casing: on diameter: (i	10 feet PUC PVC
Method of Measurement (circle one) ste Hole depth: Well dep Type of grout (circle one): Cement Casing length: S feet Casing Screen length: feet Screen Screen slot size: O / J inches	eel tape electric tape air line other: oth: Well grouted to a depth of Bentonite Mix g diameter: ' inches Type of casing: on diameter: inches Type of screen: Setting depth: From feet to7	10 feet PVC VC
Method of Measurement (circle one) ste Hole depth: Well dep Type of grout (circle one): Cement Casing length: S feet Casing Screen length: feet Screen Screen slot size: O / J inches	eel tape electric tape air line other: oth: Well grouted to a depth of Bentonite Mix g diameter: ' inches Type of casing: on diameter: inches Type of screen: Setting depth: From feet to7	10 feet PVC VC
Method of Measurement (circle one) ste Hole depth: Well dep Type of grout (circle one): Cement Casing length: S feet Casing Screen length: feet Screen Screen slot size: O / J inches	cel tape electric tape air line other:	Image: 10 feet
Method of Measurement (circle one) ste Hole depth: Well dep Type of grout (circle one): Cement Casing length: S feet Casing Screen length: feet Screen Screen slot size: C / J inches Type of completion (circle all applicable):	eel tape electric tape air line other: oth: Well grouted to a depth of Bentonite Mix g diameter: inches Type of casing: on diameter: inches Type of screen: Setting depth: From feet to Gravel packed Underreamed Telescoped Open I Other (describe):	Image: 10 feet Image: 1
Method of Measurement (circle one) ste Hole depth: Well dep Type of grout (circle one): Cement Casing length: S feet Casing Screen length: feet Screen Screen slot size: C / J inches Type of completion (circle all applicable): Top of lap pipe or reduction in casing:	eel tape electric tape air line other:	Image: 10 feet Image:
Method of Measurement (circle one) ste Hole depth: Well dep Type of grout (circle one): Cement Casing length: S feet Casing Screen length: feet Screen Screen slot size: C / J inches Type of completion (circle all applicable): Top of lap pipe or reduction in casing: Logs run (circle all applicable): No log run Name of organization running log(s):	eel tape electric tape air line other:	Image:
Method of Measurement (circle one) ste Hole depth: Well dep Type of grout (circle one): Cement Casing length: S feet Casing Screen length: feet Screen Screen slot size: (J inches Type of completion (circle all applicable): Top of lap pipe or reduction in casing: Logs run (circle all applicable): No log run Name of organization running log(s): I certify that the well was drilled, construct	eel tape electric tape air line other:	Image:
Method of Measurement (circle one) ste Hole depth: Well dep Type of grout (circle one): Cement Casing length: S feet Casing Screen length: feet Screen Screen slot size: O / J inches Type of completion (circle all applicable): Top of lap pipe or reduction in casing: Logs run (circle all applicable): No log run Name of organization running log(s): I certify that the well was drilled, construct Department of Environmental Quality and	eel tape electric tape air line other:	Image:
Method of Measurement (circle one) ste Hole depth: Well dep Type of grout (circle one): Cement Casing length: S feet Casing Screen length: feet Screen Screen slot size: (J inches Type of completion (circle all applicable): Top of lap pipe or reduction in casing: Logs run (circle all applicable): No log run Name of organization running log(s): I certify that the well was drilled, construct	eel tape electric tape air line other:	Image:
Method of Measurement (circle one) ste Hole depth: Well dep Type of grout (circle one): Cement Casing length: S feet Casing Screen length: feet Screen Screen slot size: O / J inches Type of completion (circle all applicable): Top of lap pipe or reduction in casing: Logs run (circle all applicable): No log run Name of organization running log(s): I certify that the well was drilled, construct Department of Environmental Quality and	eel tape electric tape air line other: oth:	Image:

- •

If well telescopes please sketch below and show depths.

Ground Level

,

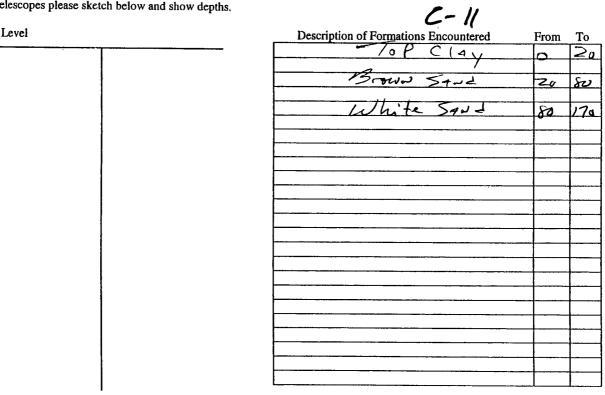

If more than one screen, show location of each on sketch

Sketch the property layout and include the following: 1) the well location; 2) any permanent structures on the property that may aid in locating the well; 3) any roads, power lines, or other items that may aid in locating the property and the well; 4) indicate direction.			
4) indicate direction.	/		
Camp			
	,		
BALL Springs Rd			
Landowner Name:			

Signature of Water Well Contractor

201 d b 1995 BROLWA

STATE WELL REPORT			
County: Cafayeffe Permit #: Permit #: Driller: Leeper Drilling Date completed: grade State completed: grade This report should be prepared by the pump installer in deta	For Office Use Only: s Completion Report to of Environmental Quality and Water Resources Box 10631 4S 39289-0631 1961-5210 4-6938 (fax) II and filed with the Department within 30 days of the		
installation of pump. Well Owner Information	Well Location		
Owner Name: DWHin Acker			
Mailing Address: 25 Bay Springs R	Latitude: Longitude: Method of Lat/Long (circle one): Conventional Survey,		
Dxford MS 38655 City State Zip Code Telephone No. 662 816-0150	USGS quad, Hand-held GPS, Survey-grade GPS $\begin{array}{c} \underline{} 4 & \underline{} 2 & \underline{} 7 & \underline{} 8 \\ \underline{} 4 & \underline{} 2 & \underline{} 7 & \underline{} 8 \\ \underline{} 14 & \underline{} 2 & \underline{} 7 & \underline{} 8 \\ \underline{} 14 & \underline{} 2 & \underline{} 7 & \underline{} 8 \\ \underline{} 14 & \underline{} 2 & \underline{} 7 & \underline{} 8 \\ \underline{} 14 & \underline{} 8 & \underline{} 2 & \underline{} 7 & \underline{} 8 \\ \underline{} 14 & \underline{} 8 & \underline{} 8 \\ \underline{} 14 & \underline{} 8 & \underline{} 8 \\ \underline{} 14 & \underline{} 8 & \underline{} 8 \\ \underline{} 14 & \underline{} 8 & \underline{} 8 \\ \underline{} 14 & \underline{} 8 & \underline{} 8 \\ \underline{} 14 & \underline{} 8 & \underline{} 8 \\ \underline{} 14 & \underline{} 8 & \underline{} 8 \\ \underline{} 14 & \underline{} 8 & \underline{} 8 \\ \underline{} 14 & \underline{} 8 & \underline{} 8 \\ \underline{} 14 & \underline{} 8 & \underline{} 8 \\ \underline{} 14 & \underline{} 8 & \underline{} 8 \\ \underline{} 14 & \underline{} 8 & \underline{} 8 \\ \underline{} 14 & \underline{} 8 & \underline{} 8 \\ \underline{} 14 & \underline{} 8 & \underline{} 8 \\ \underline{} 14 & \underline{} 8 & \underline{} 8 \\ \underline{} 14 & \underline{} 8 & \underline{} 8 \\ \underline{} 14 & \underline{} 8 & \underline{} 8 \\ \underline{} 14 & \underline{} 14 \\ \underline{} 14 \\ \underline{} 14 & \underline{} 14 \\ \underline{} 14 & \underline{} 14 \\ \underline{} 14 \\ \underline{} 14 & \underline{} 14 \\ \underline{} 1$		
Ритр Туре	Power Type		
Circle one	Circle one		
Air Lift Jet Submersible	Diesel Engine Gasoline Engine Natural Gas		
Bucket Piston Turbine	Electric Motor Hand Tractor PTO		
Centrifugal Rotary Flowing Well	Windmill Other (specify):		
Other (specify):	Horse Power Rating of Motor:		
Date Pump Installed: <u><u><u>s</u> - 11-</u> 0</u>	Setting Depth: <u>/20</u> feet		
Rated Pump Capacity:/ QGallons Per Minute	Number of Stages: <i>i</i> (
Pump Test Data Date Well Tested:	Method of Measuring Water Level Circle one Air Line Electric Measuring Line Steel Tape		
Pumping Water Level (B):Feet Below Land Surface	Other (specify):		
Drawdown [(B) - (A)]:Feet Below Land Surface	For flowing well, measured shut in head:feet		
Test Pumping Rate:Gallons Per Minute	Well yieldedGPM with a drawdown of		
Duration of Pump Test (minimum 4 hours):hours	feet afterhours of pumping		
I HEREBY CERTIFY that the above statements are true to the best of my knowledge Leeper Rilling 00.79 Print Name of Pump Installer and Lidense No. (if applicable) Signature of Pump Installer			

*

.