

Lafayette
 2817
 11-14-75


MISSISSIPPI
 BOARD OF WATER COMMISSIONERS
 416 North State Street
 Jackson, Mississippi 39201

Grid

WATER WELL DRILLERS LOG


Nov 14 1975 T medlin Lafayette
 date well completed firm name county well located

LANDOWNER:	description of formations encountered	from	to
Little Sohn	CLAY -	0	40
(mailing address)	Sand & low rocks	40	190

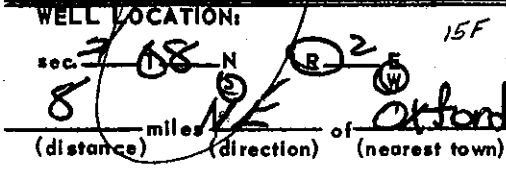

WELL PURPOSE:
 (home, irrigation, municipal, industrial)

- WELL COMPLETION DATA:
- (1) diameter (inches) 4
 - (2) total depth (feet) 190
 - (3) static water level (feet) 150 ^{below} above top of ground.
 - (4) casing RL, 190
 (material) (depth)
 4 (size) if telescope see back.
 - (5) screen 10 180
 (length) (depth to top)
 4 RL
 (size) (material)
 - (6) pump 1/2 10
 (HP) (yield gpm)
 Elec.
 (type power)
 - (7) electric log (yes or no)
 - (organization running log)
 - (8) how well bottom plugged

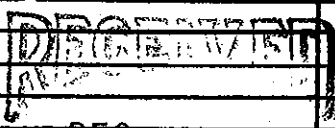

DEC - 8 1975

DRILLERS REMARKS: