

LAFAYETTE MISSISSIPPI BOARD OF WATER COMMISSIONERS 7

D 06  
S-63

WATER WELL DRILLERS LOG

**CODED**

2/26/69

Date: May, 1968, Driller: Boetjans County Lafayette  
(Name)

(1) Owner of Land:	Description & Color of Materials Sand, Clay, Red Clay, Shell, etc.	Thick- ness Feet	Depth Feet
<u>Government land</u> (Name) <u>of Ford College</u> (Address)	<u>Red sand</u>	<u>100</u>	<u>30</u>
(2) Location: <u>2, 4</u> <u>75</u> <u>1W</u> T R			
<u>1/4</u> miles <u>north east</u> of <u>Atwood</u> <u>Miss</u> (distance) (direction) (Nearest Town)			
(3) Topography: <u>Hilly</u> (Hilly) (Flat) (Level)			
(4) Purpose of Well: <u>for Government project</u> (Domestic Irrigation Municipal, Industrial, Other)			

Information upon completion of well:

(1) Diameter: 4 inches.

(2) Total Depth: 208 feet.

(3) Water Level: 50 feet below top of ground.

(4) Cased to: 220, Size 4.

(5) Screen: Size 3, Length 20.


(6) Were any formations sealed against pollution?  
 yes,  no.

**CODED**

If YES depth of formation: 40 ft to 200 ft

Why: \_\_\_\_\_

Drillers Remarks: \_\_\_\_\_

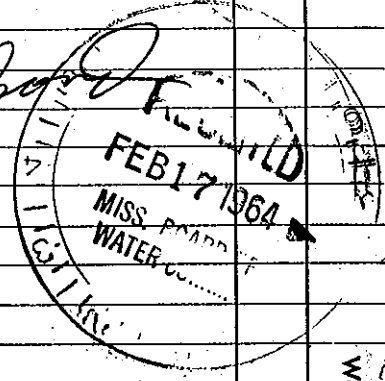

Well No.

(Use Back Side)

Mail this copy to Board of Water Commissioners 429 Miss. St. Jackson, Miss.