

LAFAYETTE MISSISSIPPI BOARD OF WATER COMMISSIONERS

E10

WATER ^{Codes} DRILLERS LOG 12/10/64 1897

CODED

12-15-64
GW-639

Date: December 15, 1964, Driller: Layne-Central Company County Lafayette

(Name) Cleveland Miss

(1) Owner of Land: College Hill Water Assn.
(Name)
Oxford, Mississippi
(Address)



(2) Location: NW 1/4, NE 1/4, Sec. 1 T. 8 S. R. 4 W.
_____ miles _____ of Oxford
(distance) (direction) (Nearest Town)

(3) Topography: flat
(Hilly) (Flat) (Level)

(4) Purpose of Well: domestic
(Domestic Irrigation
Municipal, Industrial, Other)

Description & Color of Materials Sand, Clay, Red Clay, Shell, etc.	Thick- ness Feet	Depth Feet
Hill clay	11	11
Sandy clay	5	16
Clay	3	19
Sand and clay streaks	116	135
Clay	6	141
Sand	4	145
Clay	3	148
Sand	43	191
Clay	7	198

CODED

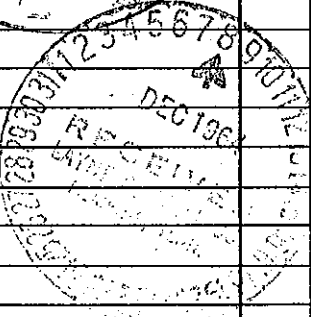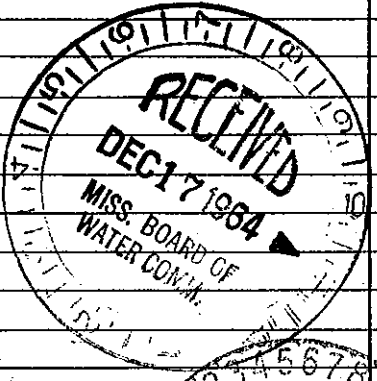

Information upon completion of well:

(1) Diameter 6x4 inches.

(2) Total Depth 199'6" feet.

(3) Water Level 104 feet below top of ground.

(4) Cased to 151'11", Size 6"
21'9" lap 4"

(5) Screen: Size 4", Length 40'3"
4" B.P.V. 7'4"

(6) Were any formations sealed against pollution?
8" of 6x4 lead seal
yes yes, no no.

If YES depth of formation Cemented,
Mechanical Seal & B.P.V.
Why _____

Drillers Remarks: _____

Well No.

(Use Back Side)

Mail this copy to Board of Water Commissioners 429 Miss. St. Jackson, Miss.