

LAF.
 FE 13
 11-26-60

WATER WELL DRILLERS LOG

E 302
 Code


Date: 11-26, 1960, Driller: Elliott Hardware county W Lafayette
 (Name)

(1) Owner of Land	Description & Color of Materials Sand, Clay, Red Clay, Shell, etc.	Thick- ness Feet	Depth Feet
James Thompson <small>(Name)</small> RFD #2 - Oxford, Miss <small>(Address)</small>	Clay - Sand & Clay Sand	12 78 80	12 110 190
(2) Location: $\frac{1}{4}$ Sec <u>9</u> , T <u>8</u> S, R <u>4</u> W <u>12</u> miles <u>North West</u> of <u>Oxford</u> <small>(distance) (direction) (Nearest Town)</small>			
(3) Topography: <u>Hilly</u> <small>(Hilly) (Flat) (Level)</small>			
(4) Purpose of Well: <u>Domestic</u> <small>(Domestic Irrigation Municipal, Industrial, Other)</small>			

Information upon completion of well:

- (1) Diameter 2 inches.
- (2) Total Depth 190 feet.
- (3) Water Level 110 feet below top of ground.
- (4) Cased to _____, Size _____
- (5) Screen: Size 2", Length 6"
- (6) Were any formations sealed against pollution?
 _____ yes, no.

If YES depth of formation _____
 Why _____
 Drillers Remarks: RFD

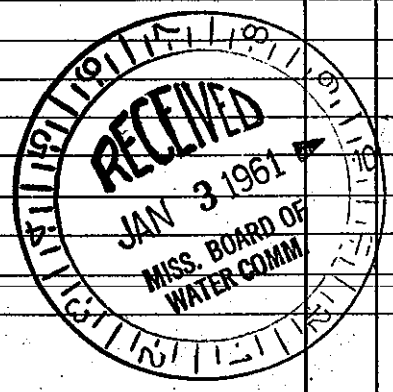

(Use Back Side)

Well No. _____

Retain this copy for your office files.