

F. 15
7-13-60

MISSISSIPPI BOARD OF WATER COMMISSIONERS

WATER WELL DRILLERS LOG

~~F301~~

Date: 7/13/, 1960, Driller: Elliott Howe Co County: Lafayette
(Name)


(1) Owner of Land: Willis Hibler
(Name)
RFD # 2 - Oxford, Miss.
(Address)
(2) Location: S 1/4, S 2 1/4, Sec 26 T 8 R 4
2 miles West of Oxford
(distance) (direction) (Nearest Town)
(3) Topography: Flat
(Hilly) (Flat) (Level)
(4) Purpose of Well: Domestic
(Domestic Irrigation, Municipal, Industrial, Other)

Description & Color of Materials Sand, Clay, Red Clay, Shell, etc.	Thick- ness Feet	Depth Feet
Hard clay	12'	12'
Sand & Clay	98'	110'
Water Sand	11'	121'

Open

Information upon completion of well:

(1) Diameter 2 inches.
(2) Total Depth 121 feet.
(3) Water Level 50' feet below top of ground.
(4) Cased to _____, Size _____
(5) Screen: Size 2", Length 6'
(6) Were any formations sealed against pollution?
_____ yes, X no.

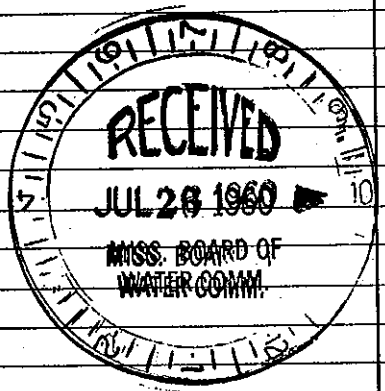

If YES depth of formation _____
Why _____
Drillers Remarks: _____

Well No.
F301

(Use Back Side)