

MISSISSIPPI BOARD OF WATER COMMISSIONERS

WATER WELL DRILLERS LOG

F. E 16  
 9-29-60  
 Date: 9-29, 1960, Driller: Elliott Hardware County: La Fayette  
 (Name)

E300


	Description & Color of Materials Sand, Clay, Red Clay, Shell, etc.	Thick- ness Feet	Depth Feet
(1) Owner of Land: <u>A.T. Bunch Jr</u> (Name) <u>Okford, Miss. RT. 2</u> (Address)	<u>clay</u>		
(2) Location: <u>1/4, SW 1/4, Sec 29 T8 R4W</u> <u>5</u> miles <u>WEST</u> of <u>Okford</u> (distance) (direction) (Nearest Town)			
(3) Topography: <u>Hilly</u> (Hilly) (Flat) (Level)			
(4) Purpose of Well: <u>Domestic</u> (Domestic Irrigation Municipal, Industrial, Other)			

*Coded*

Information upon completion of well:

- (1) Diameter 2 inches.
- (2) Total Depth 174 feet.
- (3) Water Level 120 feet below top of ground.
- (4) Cased to \_\_\_\_\_, Size \_\_\_\_\_.
- (5) Screen: Size 2", Length 5'.
- (6) Were any formations sealed against pollution?  
 \_\_\_\_\_ yes,  no.

If YES depth of formation \_\_\_\_\_  
 Why \_\_\_\_\_  
 Drillers Remarks: \_\_\_\_\_

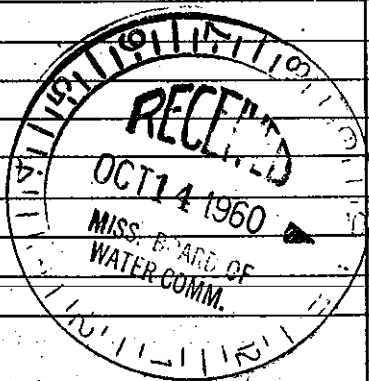

(Use Back Side)

Well No.  
E300

Retain this copy for your office files.