

MISSISSIPPI BOARD OF WATER COMMISSIONERS

E17
10-15-60
E17 WATER WELL DRILLERS LOG

E17
E301

Date: 10/15, 1960, Driller: Elliott Hardware County: bojayette
 (Name)


(1) Owner of Land: Lenna Davidson
 (Name)
Oxford, Rt 1
 (Address)
 (2) Location: 1/4, SW 1/4, Sec. 22, T8R44
8 miles West, of Oxford
 (distance) (direction) (Nearest Town)
 (3) Topography: Hilly
 (Hilly) (Flat) (Level)
 (4) Purpose of Well: Domestic
 (Domestic Irrigation, Municipal, Industrial, Other)

Description & Color of Materials Sand, Clay, Red Clay, Shell, etc.	Thick- ness Feet	Depth Feet
<u>Clay</u>	<u>10</u>	<u>10</u>
<u>Sand</u>	<u>119</u>	<u>129</u>
<u>Clay</u>	<u>3</u>	<u>132</u>
<u>Sand & Clay</u>	<u>57</u>	<u>189</u>

Coiled

Information upon completion of well:

(1) Diameter: 2 inches.
 (2) Total Depth: 189 feet.
 (3) Water Level: 60 feet below top of ground.
 (4) Cased to _____, Size _____
 (5) Screen: Size 2", Length 6 FT.
 (6) Were any formations sealed against pollution?
 _____ yes, _____ no.
 If YES depth of formation _____
 Why _____
 Drillers Remarks: _____

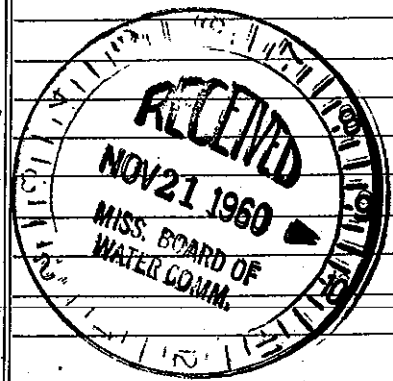

Well No.
E301

(Use Back Side)

Mail this copy to Board of Water Commissioners 429 Miss. St. Jackson, Miss.