

MISSISSIPPI BOARD OF WATER COMMISSIONERS

E 303

19
2-17-61

WATER WELL DRILLERS LOG

Date: 2-17, 1961, Driller: Elliott Hulse County: Leflore
(Name)

(1) Owner of Land: E. H. Shaw
(Name)
P.F.D. #2-
(Address)

(2) Location: 1/4, SW 1/4, Sec. 1 T8S R44E
5 miles WEST of Oxford
(distance) (direction) (nearest town)

(3) Topography: Hilly
(Hilly) (Flat) (Level)

(4) Purpose of Well: Domestic
(Domestic Irrigation, Municipal, Industrial, Other)


Description & Color of Materials Sand, Clay, Red Clay, Shell, etc.	Thick- ness Feet	Depth Feet
<u>Sand & Clay</u>	<u>126</u>	<u>126</u>
<u>Clay</u>	<u>1'</u>	<u>127</u>
<u>SAND</u>	<u>19</u>	<u>146</u>

Information upon completion of well:

- (1) Diameter 2 1/2 inches.
- (2) Total Depth 146 feet.
- (3) Water Level 94 feet below top of ground.
- (4) Cased to _____, Size _____
- (5) Screen: Size 2", Length 6'
- (6) Were any formations sealed against pollution?
_____ yes, _____ no.

Cased

If YES depth of formation _____
Why _____
Drillers Remarks: _____

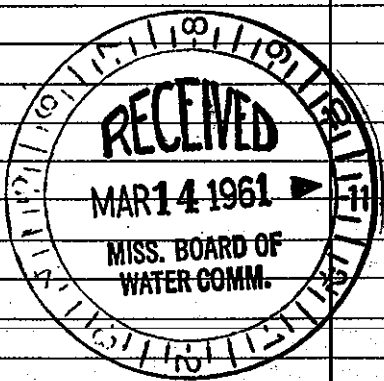

(Use Back Side)

Well No.

tain this copy for your office files.