

MISSISSIPPI BOARD OF WATER COMMISSIONERS

WATER WELL DRILLERS LOG

20
12-5-61

16

Date: 12/5, 1961, Driller: Elliott Hesse County: Lafayette

(1) Owner of Land: Edd Bible
(Name)

(Address)

(2) Location: 1/4, SE 1/4, Sec. 7 T8S R5W

miles, of
(distance) (direction) (Nearest Town)

(3) Topography: Hilly
(Hilly) (Flat) (Level)

(4) Purpose of Well: Domestic
(Domestic Irrigation
Municipal, Industrial, Other)


Description & Color of Materials Sand, Clay, Red Clay, Shell, etc.	Thick- ness Feet	Depth Feet
Clay	55	55
Sand + Clay	50	105
Black Clay	10	115
Sand + Clay -	55	160
Red Sand	10	170
Sand -	100	270
Clay	2	272

Cased

Information upon completion of well:

(1) Diameter: 4 inches.
(2) Total Depth: 272 feet.
(3) Water Level: 190 feet below top of ground.
(4) Cased to _____, Size _____
(5) Screen: Size 3", Length 10'
(6) Were any formations sealed against pollution?
_____ yes, _____ no.

If YES depth of formation _____
Why _____
Drillers Remarks: _____

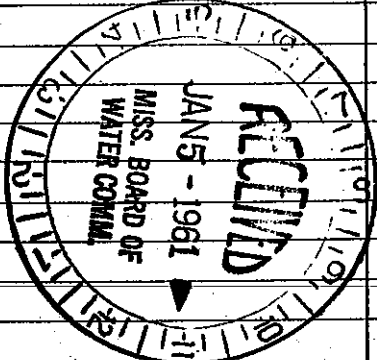

Well No.

(Use Back Side)