

MISSISSIPPI BOARD OF WATER COMMISSIONERS

AF
E 21
2-19-62

WATER WELL DRILLERS LOG

Date: 2/19, 1962, Driller: ELLIOTT HARDWARE COMPANY County: Lafayette
(Name)

(1) Owner of Land:	Description & Color of Materials Sand, Clay, Red Clay, Shell, etc.	Thick- ness Feet	Depth Feet
<u>J.H. Poljans</u> <small>(Name)</small> <u>RFD #2 Oxford</u> <small>(Address)</small>	<u>Surface Clay</u>	<u>17</u>	<u>17</u>
(2) Location: <u>1/4, NE 1/4, Sec. 1 T8N W4E</u> <u>3</u> miles <u>WEST</u> of <u>Oxford</u> <small>(distance) (direction) (Nearest Town)</small>	<u>Clay & Sand -</u>	<u>105</u>	<u>122</u>
(3) Topography: <u>Hilly</u> <small>(Hilly) (Flat) (Level)</small>	<u>Sand</u>	<u>24</u>	<u>146</u>
(4) Purpose of Well: <u>Domestic</u> <small>(Domestic Irrigation Municipal, Industrial, Other)</small>	<u>Clay</u>		<u>147</u>

Cased

Information upon completion of well:

(1) Diameter 2 inches.

(2) Total Depth 147 feet.

(3) Water Level 110 feet below top of ground.

(4) Cased to No, Size _____.


(5) Screen: Size 2", Length 5.

(6) Were any formations sealed against pollution?
 _____ yes, _____ no.

If YES depth of formation _____.

Why _____.

Drillers Remarks: _____

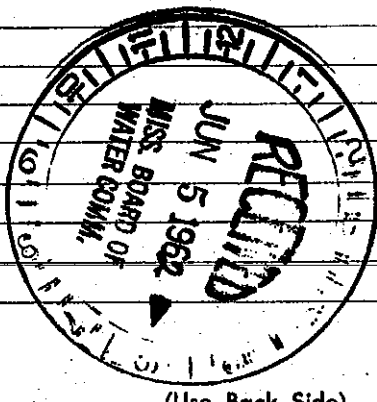

(Use Back Side)

Well No.

Retain this copy for your office files.