

LAF,
E24
5-10-62

MISSISSIPPI BOARD OF WATER COMMISSIONERS

WATER WELL DRILLERS LOG

Date: 5/10, 1962, Driller: Elliott Hardaway County Jefferson
(Name)


(1) Owner of Land: P. P. Shaw
(Name)
RFD #3 - Oxford, Miss
(Address)
(2) Location: 1/4, NE 1/4, Sec. 1 T8S R4E
4 miles North West of Oxford
(distance) (direction) (Nearest Town)
(3) Topography: Hilly
(Hilly) (Flat) (Level)
(4) Purpose of Well: Domestic
(Domestic Irrigation
Municipal, Industrial, Other)

Description & Color of Materials Sand, Clay, Red Clay, Shell, etc.	Thick- ness Feet	Depth Feet
<u>Clay</u>	<u>21</u>	<u>21</u>
<u>Sand & clay</u>	<u>72</u>	<u>113</u>
<u>Sand</u>	<u>47</u>	<u>139</u>
<u>Coiled</u>		

Information upon completion of well:

(1) Diameter 2" inches.
(2) Total Depth 139 feet.
(3) Water Level 72 feet below top of ground.
(4) Cased to NO, Size _____
(5) Screen: Size 2", Length 6'
(6) Were any formations sealed against pollution?
_____ yes, no.

If YES depth of formation _____
Why _____
Drillers Remarks: _____

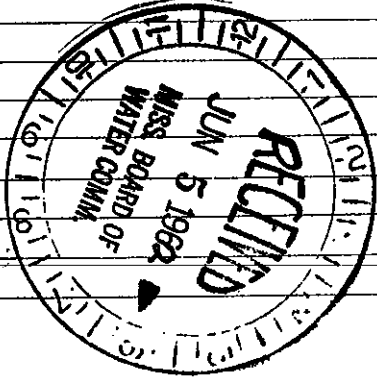

(Use Back Side)

Well No.