

MISSISSIPPI BOARD OF WATER COMMISSIONERS

L.A.F.  
E25

7-26-62

WATER WELL DRILLERS LOG

Date: 7-26, 1962, Driller: E. H. Hume County La Fayette  
(Name)


(1) Owner of Land: Allen Simms  
(Name)  
RT-3 - Box 131 - Oxford  
(Address)  
(2) Location: 1/4, 1/4, Sec. 1 T8S R4W  
4 miles West, of Oxford  
(distance) (direction) (Nearest Town)  
(3) Topography: Hilly  
(Hilly) (Flat) (Level)  
(4) Purpose of Well: Domestic  
(Domestic Irrigation  
Municipal, Industrial, Other)

Description & Color of Materials Sand, Clay, Red Clay, Shell, etc.	Thick- ness Feet	Depth Feet
<u>Sand &amp; Clay</u>	<u>123</u>	<u>123</u>
<u>Pink Clay</u>		<u>124</u>

Information upon completion of well:

(1) Diameter 2" inches.  
(2) Total Depth 124 feet.  
(3) Water Level 75 feet below top of ground.  
(4) Cased to \_\_\_\_\_, Size \_\_\_\_\_  
(5) Screen: Size 2", Length 6"  
(6) Were any formations sealed against pollution?  
\_\_\_\_\_ yes, \_\_\_\_\_ no.  
If YES depth of formation \_\_\_\_\_  
Why \_\_\_\_\_  
Drillers Remarks: \_\_\_\_\_

*Coded*

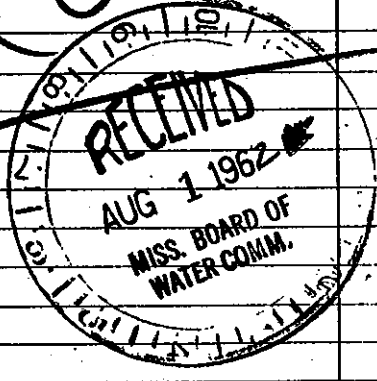

Retain this copy for your office files.

(Use Back Side)

Well No.