

L.A.F.
E26
10-16-62

MISSISSIPPI BOARD OF WATER COMMISSIONERS

WATER WELL DRILLERS LOG

Date: 10/16, 1962, Driller: Leffert Hardware Co. Lafayette
(Name)


(1) Owner of Land:	Description & Color of Materials Sand, Clay, Red Clay, Shell, etc.	Thick- ness Feet	Depth Feet
<u>Robert Tolbert</u> (Name) <u>Rt 2 - Oxford</u> (Address)	<u>Red Clay</u>	<u>40</u>	<u>40</u>
(2) Location: <u>1/4</u> , <u>1/4</u> , Sec. <u>8</u> T <u>8</u> R <u>44</u> W	<u>Sand & White Clay</u>	<u>34</u>	<u>74</u>
<u>8</u> miles <u>N. West</u> , of <u>Oxford</u> (distance) (direction) (Nearest Town)	<u>Blue Clay - d</u>	<u>96</u>	<u>170</u>
(3) Topography: <u>Hilly</u> (Hilly) (Flat) (Level)	<u>Rock -</u>	<u>18</u>	<u>188</u>
(4) Purpose of Well: <u>Domestic</u> (Domestic Irrigation Municipal, Industrial, Other)	<u>Green Sandy Clay</u>	<u>60</u>	<u>248</u>
	<u>Blue Clay</u>	<u>22</u>	<u>270</u>
	<u>Blue Clay Sand</u>	<u>25</u>	<u>295</u>

Information upon completion of well:

- (1) Diameter 2 inches.
- (2) Total Depth 278 feet.
- (3) Water Level 70 feet below top of ground.
- (4) Cased to _____, Size _____
- (5) Screen: Size 2", Length 10'
- (6) Were any formations sealed against pollution?
_____ yes, no.

Handwritten signature

If YES depth of formation _____
Why _____
Drillers Remarks: _____

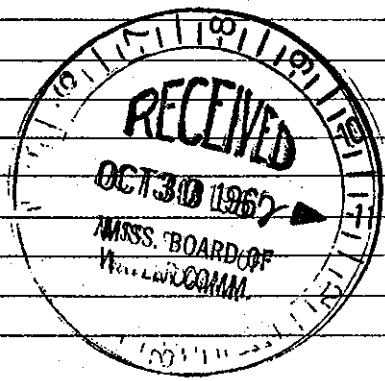

Well No. _____

(Use Back Side)

Retain this copy for your office files.