

LAF.

MISSISSIPPI BOARD OF WATER COMMISSIONERS

E 27
2-74-63

WATER WELL DRILLERS LOG

Date: Feb. 14, 1963, Driller: Elliott Hardware County Lafayette
(Name)


	Description & Color of Materials Sand, Clay, Red Clay, Shell, etc.	Thick- ness Feet	Depth Feet
(1) Owner of Land: <u>Walter Thompson</u> (Name) <u>R.F.D. #2 - Oxford, Miss</u> (Address)	Red Clay	27	27
(2) Location: <u>1/4</u> , <u>1/4</u> , Sec. <u>16 T8R4W</u> <u>7</u> miles <u>WEST</u> of <u>Oxford</u> (distance) (direction) (Nearest Town)	Red Sand & Clay	63	90
(3) Topography: <u>Hilly</u> (Hilly) (Flat) (Level)	White Clay	2	92
(4) Purpose of Well: <u>Domestic</u> (Domestic Irrigation Municipal, Industrial, Other)	FINE White Sand	48	140
	SAND	42	182

Information upon completion of well:

- (1) Diameter 2 inches.
- (2) Total Depth 182 feet.
- (3) Water Level 130 feet below top of ground.
- (4) Cased to 0, Size 0
- (5) Screen: Size 2", Length 6'
- (6) Were any formations sealed against pollution?
yes, X no.

[Large handwritten signature]

If YES depth of formation _____
Why _____
Drillers Remarks: _____

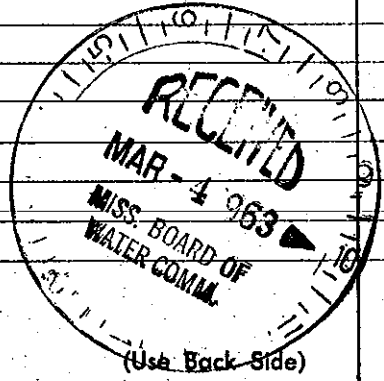

Well No. _____

Retain this copy for your office files.