

L.A.F. MISSISSIPPI BOARD OF WATER COMMISSIONERS

E28
3-15-63

WATER WELL DRILLERS LOG

Date: 3/15, 1963, Driller: Elbert H. Adair County: W. Fayette
(Name)

(1) Owner of Land: Mr. Dwight Crowe
(Name)
Oxford, Miss. - P.T. 2
(Address)

(2) Location: 1/4 SE 1/4, Sec 36, T. 56 N., R. 56 W.
7 miles West of Oxford
(distance) (direction) (Nearest Town)

(3) Topography: Hilly
(Hilly) (Flat) (Level)

(4) Purpose of Well: Domestic
(Domestic Irrigation, Municipal, Industrial, Other)

Description & Color of Materials Sand, Clay, Red Clay, Shell, etc.	Thick- ness Feet	Depth Feet
<u>Red Clay</u>	<u>82</u>	<u>82</u>
<u>SAND & Clay</u>	<u>15</u>	<u>97</u>
<u>SAND</u>	<u>5</u>	<u>102</u>
<u>Sand & Clay</u>	<u>40</u>	<u>152</u>
<u>SAND</u>	<u>20</u>	<u>162</u>
<u>PINK Clay</u>	<u>4</u>	<u>166</u>

Information upon completion of well:

(1) Diameter 4 inches.

(2) Total Depth 166 feet.

(3) Water Level 70 feet below top of ground.


(4) Cased to NO, Size _____.

(5) Screen: Size 4", Length 10'.

(6) Were any formations sealed against pollution?
_____ yes, no.

[Handwritten signature]

If YES depth of formation _____
Why _____
Drillers Remarks: _____

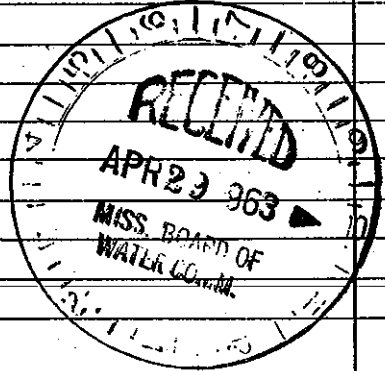

Well No.

(Use Back Side)

Retain this copy for your office files.