

LAF.
E 29

WATER WELL DRILLERS LOG

Date: 6-13-63, 1963, Driller: Elliott Hardwick County Lafayette
(Name)

(1) Owner of Land	Description & Color of Materials Sand, Clay, Red Clay, Shell, etc.	Thick- ness Feet	Depth Feet
<u>Charles Walter</u> (Name) <u>Oxford Miss</u> (Address)	<u>Red Clay</u>	<u>37</u>	<u>37</u>
(2) Location: <u>1/4</u> , <u>1/4</u> , Sec <u>25 T8R44</u> <u>4 miles West</u> , of <u>Oxford</u> (distance) (direction) (Nearest Town)	<u>SAND & Clay</u> <u>SAND</u>	<u>113</u> <u>60</u>	<u>150</u> <u>210</u>
(3) Topography: <u>Hilly</u> (Hilly) (Flat) (Level)			
(4) Purpose of Well: <u>Domestic</u> (Domestic Irrigation Municipal, Industrial, Other)			


Information upon completion of well:

- (1) Diameter 4 inches.
- (2) Total Depth 210 feet.
- (3) Water Level 90 feet below top of ground.
- (4) Cased to No., Size 2" x 10.
- (5) Screen: Size 2", Length 10.
- (6) Were any formations sealed against pollution?
_____ yes, No no.

If YES depth of formation _____

Why _____

Drillers Remarks: _____

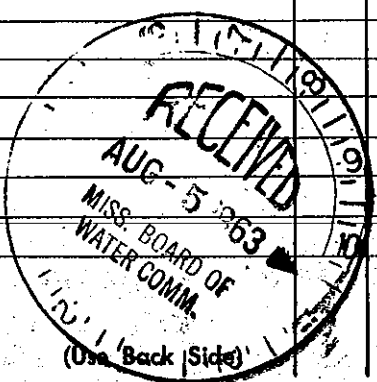

Well No. _____

Retain this copy for your office files.