

LAF. MISSISSIPPI BOARD OF WATER COMMISSIONERS

E 30
6-18-63

WATER WELL DRILLERS LOG

Date: 6/18, 1963, Driller: Elliott Howe County: Lafayette
(Name)

(1) Owner of Land: Roger Thompson
(Name)
P.F.D. #2 Oxford, Miss
(Address)

(2) Location: 1/4, 1/4, Sec. 22 T85R4W
5 miles west of Oxford
(distance) (direction) (Nearest Town)

(3) Topography: Hilly
(Hilly) (Flat) (Level)

(4) Purpose of Well: Domestic
(Domestic Irrigation
Municipal, Industrial, Other)

Description & Color of Materials Sand, Clay, Red Clay, Shell, etc.	Thick- ness Feet	Depth Feet
<u>Red Clay</u>	<u>25</u>	<u>35</u>
<u>Sand + Clay</u>	<u>17</u>	<u>52</u>
<u>Clay with</u>	<u>5</u>	<u>57</u>
<u>SAND + Clay</u>	<u>90</u>	<u>147</u>
<u>SAND</u>	<u>21</u>	<u>168</u>

Information upon completion of well:

(1) Diameter: 2" inches.

(2) Total Depth: 168 feet.

(3) Water Level: 120 feet below top of ground.

(4) Cased to: No, Size: No


(5) Screen: Size: 2", Length: 10'

(6) Were any formations sealed against pollution?
no

If YES depth of formation _____

Why _____

Drillers Remarks: _____

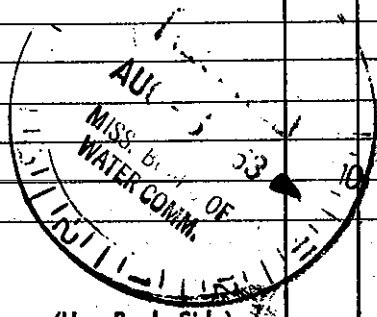

(Use Back Side)

Well No. _____

Mail this copy to Board of Water Commissioners 429 Miss. St. Jackson, Miss.