

LAF. MISSISSIPPI BOARD OF WATER COMMISSIONERS

OE 31
10-10-63

WATER WELL DRILLERS LOG


Date: 10/10, 1963, Driller: ELLIOTT HARDWARE COMPANY
OXFORD, MISSISSIPPI County Lafayette

	Description & Color of Materials Sand, Clay, Red Clay, Shell, etc.	Thick- ness Feet	Depth Feet
(1) Owner of Land: John Leslie (Name) Oxford, Miss (Address)	Red Clay	24	24
(2) Location: 1/4, N 1/4, Sec. 12 6 miles N.W. of Oxford (distance) (direction) (Nearest Town)	Sand	36	60
(3) Topography: Hilly (Hilly) (Flat) (Level)	Clay - Sand	26	86
(4) Purpose of Well: Domestic (Domestic Irrigation Municipal, Industrial, Other)	Clay - Sand	10	96
	Blue Clay	12	108
	Black Clay	37	145
	Hard Clay -	50	195
	FINE Mica Sand	90	285
		140	423
		83	506

Information upon completion of well:

- (1) Diameter 4 inches.
- (2) Total Depth 145 feet.
- (3) Water Level 90 feet below top of ground.
- (4) Cased to No., Size V
- (5) Screen: Size 2 1/2, Length 10
- (6) Were any formations sealed against pollution?
yes, no.

If YES depth of formation _____
Why _____
Drillers Remarks: _____

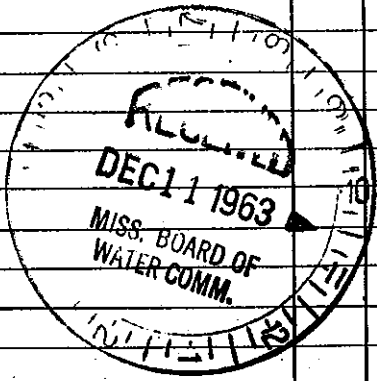

(Use Back Side)

Well No.

Retain this copy for your office files.