

L.A.F. MISSISSIPPI BOARD OF WATER COMMISSIONERS

E 32 WATER WELL DRILLERS LOG
2-20-64


Date: Feb 20 1964, Driller: Elliott H. Hume, C. County Lafayette
(Name)

(1) Owner of Land	Description & Color of Materials Sand, Clay, Red Clay, Shell, etc.	Thick- ness Feet	Depth Feet
(Name) <u>Ben Walker</u> (Address) <u>Oxford, Miss. Rt. 2.</u>	<u>Clay</u> <u>Sand & clay</u> <u>Sand</u>	<u>22</u> <u>138</u> <u>50</u>	<u>22</u> <u>160</u> <u>210</u>
(2) Location: $\frac{1}{4}$, $\frac{1}{4}$, Sec. <u>31 T. 8, R. 4</u>			
<u>9</u> miles <u>West</u> , of <u>Oxford</u> (distance) (direction) (Nearest Town)			
(3) Topography: (Hilly) (Flat) (Level)			
(4) Purpose of Well: <u>Domestic</u> (Domestic Irrigation Municipal, Industrial, Other)			

Information upon completion of well:

- (1) Diameter 4" inches.
- (2) Total Depth 210 feet.
- (3) Water Level 7.5 feet below top of ground.
- (4) Cased to 189, Size 4"
- (5) Screen: Size 2 1/2", Length 10'
- (6) Were any formations sealed against pollution?
 yes, no.

If YES depth of formation _____
 Why _____
 Drillers Remarks: _____

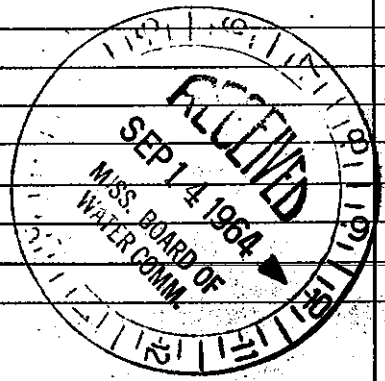

(Use Back Side)

Well No.

Retain this copy for your office files.