

L.A.F. MISSISSIPPI BOARD OF WATER COMMISSIONERS

E 34
3-17-64

WATER WELL DRILLERS LOG


Date: 3-17, 1964, Driller: Elliott Hardware County Leflore
(Name)

(1) Owner of Land	Description & Color of Materials Sand, Clay, Red Clay, Shell, etc.	Thick- ness Feet	Depth Feet
<u>Bill Siebler</u> (Name) <u>Oxford, Miss</u> (Address)	<u>SAND</u>	<u>77</u>	<u>77</u>
(2) Location: <u>1/4</u> , <u>1/4</u> , Sec. <u>25 T5R4</u> <u>3</u> miles <u>west</u> of <u>Oxford</u> (distance) (direction) (Nearest Town)	<u>Pink clay-</u>	<u>18</u>	<u>78</u>
(3) Topography: <u>Hilly</u> (Hilly) (Flat) (Level)			
(4) Purpose of Well: <u>Domestic</u> (Domestic Irrigation Municipal, Industrial, Other)			

Information upon completion of well:

- (1) Diameter 2" inches.
- (2) Total Depth 78 feet.
- (3) Water Level 30 feet below top of ground.
- (4) Cased to No, Size No
- (5) Screen: Size 2", Length 5'
- (6) Were any formations sealed against pollution?
no yes, X no.

If YES depth of formation _____
Why _____
Drillers Remarks: _____

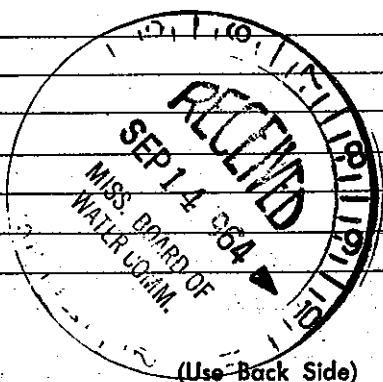

Well No. _____