

LAF.
E 36
9-3-64

MISSISSIPPI BOARD OF WATER COMMISSIONERS

WATER WELL DRILLERS LOG


Date: Sept 3, 1964, Driller: Elliott Hdw. Co. County: Lef
(Name)

(1) Owner of Land:	Description & Color of Materials Sand, Clay, Red Clay, Shell, etc.	Thick- ness Feet	Depth Feet
(Name) <u>Roman Furr</u>	Clay	14	14
(Address) <u>Oxford Miss.</u>	Sand and clay	51	65
(2) Location: $\frac{1}{4}$, $\frac{1}{4}$, Sec. <u>25 T. 8 R. 4</u>	Clay	15	80
<u>3</u> miles <u>west</u> of <u>Oxford</u>	Sand and clay	56	136
(distance) (direction) (Nearest Town)	water sand	10	146
(3) Topography: <u>Hilly</u>			
(4) Purpose of Well: <u>Domestic</u>			
(Domestic Irrigation Municipal, Industrial, Other)			

Information upon completion of well:

- (1) Diameter: 2 inches.
- (2) Total Depth: 146 feet.
- (3) Water Level: 82 feet below top of ground.
- (4) Cased to _____, Size _____
- (5) Screen: Size 2, Length 5 ft.
- (6) Were any formations sealed against pollution?
 yes, no.

If YES depth of formation _____
 Why _____
 Drillers Remarks: _____

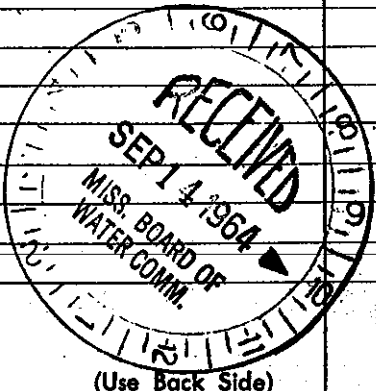

Well No. _____

Retain this copy for your office files.