

LAF. MISSISSIPPI BOARD OF WATER COMMISSIONERS

E38
6-8-65

WATER WELL DRILLERS LOG

Date: June 8, 1965, Driller: Elliot Howe County Lafayette
(Name)

(1) Owner of Land:	Description & Color of Materials Sand, Clay, Red Clay, Shell, etc.	Thick- ness Feet	Depth Feet
<u>E. A. Shaw</u> (Name)	<u>Clay</u>	<u>41</u>	<u>41</u>
<u>Offord, Miss Rt 3</u> (Address)	<u>Sand & Clay</u>	<u>33</u>	<u>74</u>
(2) Location: <u>1/4, 1/4, Sec. 1 T. 4 R. 4</u>	<u>Sand - "brown"</u>	<u>15</u>	<u>89</u>
<u>5</u> miles <u>West</u> of <u>Offord</u> (distance) (direction) (Nearest Town)	<u>Water Sand</u>	<u>21</u>	<u>110</u>
(3) Topography: <u>Hilly</u> (Hilly) (Flat) (Level)			
(4) Purpose of Well: <u>Domestic</u> (Domestic Irrigation Municipal, Industrial, Other)			


Information upon completion of well:

- (1) Diameter 2 inches.
- (2) Total Depth 110 feet.
- (3) Water Level 70 feet below top of ground.
- (4) Cased to _____, Size _____.
- (5) Screen: Size 2", Length _____.
- (6) Were any formations sealed against pollution?
_____ yes, _____ no.

If YES depth of formation _____

Why _____

Drillers Remarks: _____

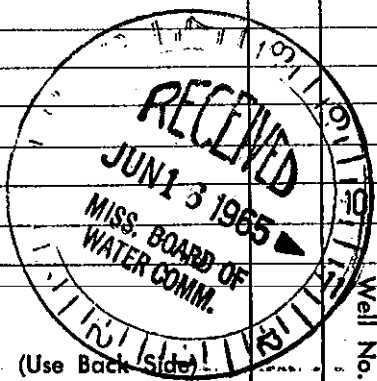

Retain this copy for your office files.