

LAF.
E 40
6-21-65

MISSISSIPPI BOARD OF WATER COMMISSIONERS

WATER WELL DRILLERS LOG


Date: 6-21, 1965, Driller: Elliott Howard Lafayette
(Name)

(1) Owner of Land:	Description & Color of Materials Sand, Clay, Red Clay, Shell, etc.	Thick- ness Feet	Depth Feet
<u>Jack McCormick</u> (Name) <u>Oxford, Miss</u> (Address)	<u>Clay</u>	<u>40</u>	<u>40</u>
(2) Location: <u>1/4 SW 1/4, Sec 24 T 85 N R 4 E</u>	<u>Sand & Clay</u>	<u>63</u>	<u>103</u>
<u>4</u> miles <u>West</u> of <u>Oxford</u> (distance) (direction) (Nearest Town)	<u>Sand</u>	<u>12</u>	<u>115</u>
(3) Topography: <u>Hilly</u> (Hilly) (Flat) (Level)	<u>Sand & Clay</u>	<u>55</u>	<u>170</u>
(4) Purpose of Well: <u>Domestic</u> (Domestic Irrigation Municipal, Industrial, Other)	<u>Sand</u>	<u>16</u>	<u>186</u>

Information upon completion of well:

- (1) Diameter 4 inches.
- (2) Total Depth 186 feet.
- (3) Water Level 110 feet below top of ground.
- (4) Cased to , Size
- (5) Screen: Size 4" , Length 10'
- (6) Were any formations sealed against pollution?
 yes, no.

If YES depth of formation _____
Why _____
Drillers Remarks: _____

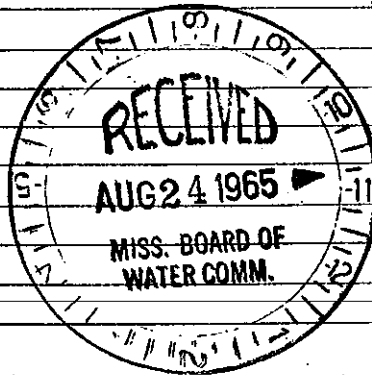

Well No. _____

(Use Back Side)

Retain this copy for your office files.