

MISSISSIPPI

LAFAYETTE

WATER WELL DRILLERS LOG

E 42

7-8-66

Date: 7-8-66, Driller: Elliott Hall County Lafayette

(Name)

(1) Owner of Land: Olivia Blake
At 2 - Oxford

(2) Location: 1/4, 1/4, Sec. 16 T8R4W
8 miles West of Oxford

(3) Topography: Hilly

(4) Purpose of Well: Domestic

Description & Color of Materials Sand, Clay, Red Clay, Shell, etc.	Thick- ness Feet	Depth Feet
3" Clay - Red	30	30
Sand - Brown	35	65
Hard Clay	45	110
Sand - Fine	78	188
Clay - Black	17	205
Sand -	33	238


Information upon completion of well:

- (1) Diameter 2 inches.
- (2) Total Depth 238 feet.
- (3) Water Level 158 feet below top of ground.
- (4) Cased to No, Size
- (5) Screen: Size 2", Length 6"
- (6) Were any formations sealed against pollution?
yes, no.

If YES depth of formation

Why

Drillers Remarks:

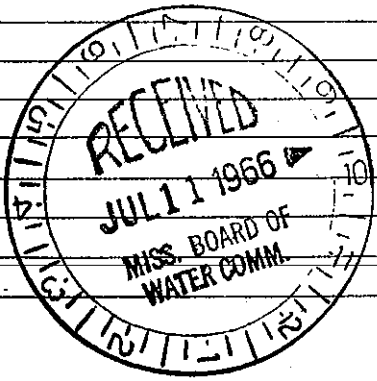

(Use Back Side)

Well No.

Retain this copy for your office files.