

Lafayette
E43

9-66 MISSISSIPPI BOARD OF WATER COMMISSIONERS

WATER WELL DRILLERS LOG

Date: Sept. 15, 1966, Driller: Jerry Roberson County Lafayette
(When well drilled) (Name) (Where well is located)

1) Owner of Land: Lloyd Oliphant
(Name)
Route 1, Oxford, Miss.
(Address)

Description & Color of Materials Sand, Clay, Red Clay, Shell, etc.	Thick- ness Feet	Depth Feet
<u>Sand + Clay</u>	<u>20</u>	<u>20</u>
<u>Clay</u>	<u>40</u>	<u>60</u>
<u>Sand clay</u>	<u>40</u>	<u>100</u>
<u>Sand</u>	<u>40</u>	<u>140</u>

2) Location: SW 1/4, SW 1/4, Sec 29 T 83 R 4 W
2 1/2 miles SW of Oxford
(distance) (direction) (Nearest Town)

3) Topography: (Hilly) (Flat) (Level)

4) Purpose of Well: Home
(Domestic Irrigation, Municipal, Industrial, Other)

Information upon completion of well:

1) Diameter 4 inches.

2) Total Depth 140 feet.

3) Water Level 80 feet below top of ground.

4) Cased to 135, Size 4 in.

5) Screen: Size 6 in., Length 5 ft.

5) Were any formations sealed against pollution?
 yes, no.

YES depth of formation _____


/by _____

Drillers Remarks: Plastic Water Well

Yield in gpm: 15 gal.

Size pump: 1/2 Horse Submerge

Type power: 220-TVA

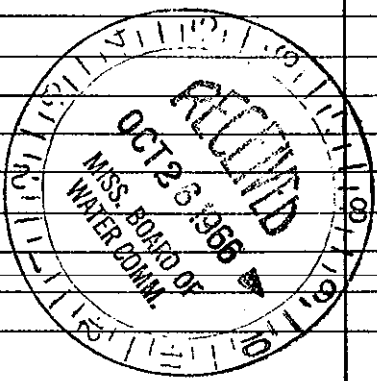

File this copy to Board of Water Commissioners 429 Miss. St. Jackson, Miss.